IREDELL COUNTY HEALTH DEPARTMENT

CI Site address: 134 Whistling Pines Dr.

STATESVILLE 704-878-5305 - MOORESVILLE 704-664-5281

IMPROVEMENT PERMIT / AUTHORIZATION TO CONSTRUCT / OPERATION PERMIT / EXISTING SYSTEM INSPECTION

PERMIT# 126586 PIN# ~~4722-69-5036.000~~ 4722-78-6920.000 (4-30-10) DATE July 18, 2005

OWNER OR CONTRACTOR Mtn. Creek Inv. II Spencer Elder. PHONE: Business _____ Home _____

ADDRESS 118 Whaling Dr. Mooresville N.C.

LOCATION From Troutman Old Mocksville Rd TR Buffalo Shoals TR Davidson Rd TR Winding Cedar TL Short Pine Ln. RT. End

SUBDIVISION Davidson Woods BLOCK / SECTION II LOT ~~30 Revised~~ 29 AREA 3.24 Ac SITE CLASS. PS DESIGN FLOW 360 gpd L.T.A.R. .25 - 3 Initial system / .3 PPBPS Repair

Septic Tank: 1000 Gallons; STB 625 Date 3-11-07

Pump Tank: _____ Gallons; PT _____ Date _____

Pump Make: _____ Model _____ Serial No. _____

Nitrification Field: No Fields 1 Square Feet 960 Linear Feet 320

No Lines 4 Trench Width 36" Max Trench Bottom Depth 30" Gravel Depth N/A

☒ New System ☐ Repair System Type: I, II, III, IV, V, VI

System Description: * Gravity 25% Reduction "Accepted"

Repair System Description: LP PPBPS

Maintenance Agreement Required: ☐ Yes ☒ No initially

☒ House/Mod. Home No. Bedrooms 3

☐ Mobile Home No. Bathrooms ____

☐ Business No. Employees ____

☐ Other _____

☐ Slab ☒ Crawl Space ☐ Basement w/plumbing ☐ Basement wo/plumbing


Water Supply: ☐ Individual ☒ Public ☐ Community

Comments:/Conditions: Lot 30 Revised is a combination of former Lots 29 & 30. House Site is "halved" by former 29/30 PL, *House Site will require fill to a level equal that or above the level of the septic tank and drainfield area.

Comments:/Conditions: Blue Filter

1" = 100'

INITIAL SITE SKETCH

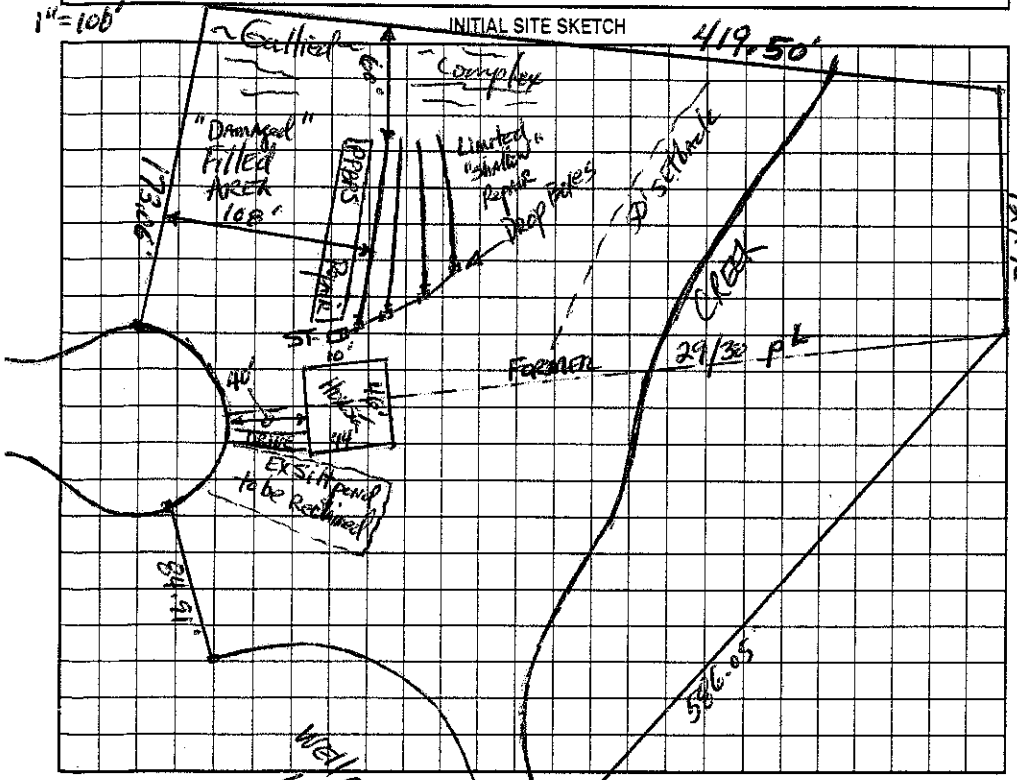

AS BUILT SKETCH

20 each endcap to endcap

Permit can be suspended or revoked if any false information is supplied toward securing the permit/any unauthorized changes are made to the site/any unauthorized changes are made in the installation of the system. Improvement Permit with plat valid without expiration. Improvement Permit with site plan valid for sixty months. Authorization to Construct is valid for a period equal to that of Improvement Permit – not to exceed sixty months.

Signed: _____ date 4/20/05 Installed by: Rowan Septic

Improvement Permit by: D. Hinson, RS date 7-18-05 Operation Permit by: _____ date 4-27-07

Authorization to Construct by: D. Hinson, RS date 7-18-05 Existing System Inspection by: _____ date _____

HEALTH DEPT. COPY: WHITE OWNER COPY (FINAL): YELLOW OWNER COPY (INITIAL): PINK