IREDELL COUNTY HEALTH DEPARTMENT

STATESVILLE 704-878-5305 (1300 Paid) MOORESVILLE 704-664-5281

IMPROVEMENT PERMIT / AUTHORIZATION TO CONSTRUCT / OPERATION PERMIT / EXISTING SYSTEM INSPECTION

PERMIT# 119991 PIN# ~~4722-79-1840.36~~ 4922-79-0318 DATE Oct 28, 04

OWNER OR CONTRACTOR Mr. Gerald Jr. & Spence Bibles PHONE: Business _____ Home _____

ADDRESS 125 Whaling DR, Mooresville NC 28117

LOCATION From Treadmen - Old Mtn Rd TR Buffalo Shoals TR Davidson Rd. TR Winding Cedar TL Short Pine 2nd Lot on Right

SUBDIVISION Davidson Woods BLOCK / SECTION II LOT 36 LOT AREA 20,000ft² SITE CLASS. PS DESIGN FLOW 360gpd L.T.A.R. .25

Septic Tank: 1000 Gallons; STB 825 Date 6/4/05
Pump Tank: 1000 Gallons; PT 302 Date 7/17/05
Pump Make: Zoeller Model N 98 Serial No. _____
Nitrification Field: No Fields 1 Square Feet 1080 Linear Feet 360
No Lines 4@90' Trench Width 36" Max Trench Bottom Depth 36" Gravel Depth NA

☑ New System ☐ Repair System Type: I, II, III, IV, V, VI
System Description: pm 25% Reduction
Repair System Description: LPPPBPS
Maintenance Agreement Required: ☐ Yes ☑ No ~~Initially~~

☑ House/Mod. Home No. Bedrooms 3
☐ Mobile Home No. Bathrooms 2
☐ Business No. Employees ____
☐ Other _____


☐ Slab ☑ Crawl Space ☐ Basement w/plumbing ☐ Basement wo/plumbing

Water Supply: ☐ Individual ~~☑ Public~~ ~~☑ Community~~


Comments:/Conditions:
"Shave off" old burn
Pump spec: 36gal/min @ 25' TDH

Comments:/Conditions: SF w/ MARKER AND POLY LOK FILTER
INSTALLED AS DRAWN WITH 90 QUICK-4 INFILTRATORS.
SW 9/27/05

INITIAL SITE SKETCH

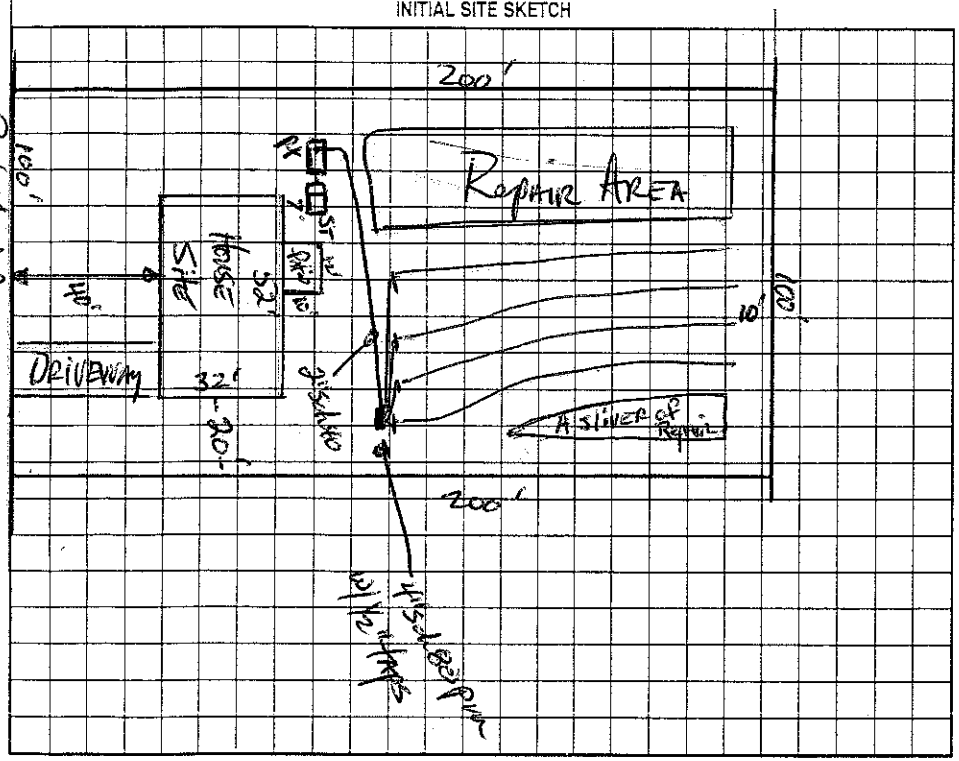

AS BUILT SKETCH

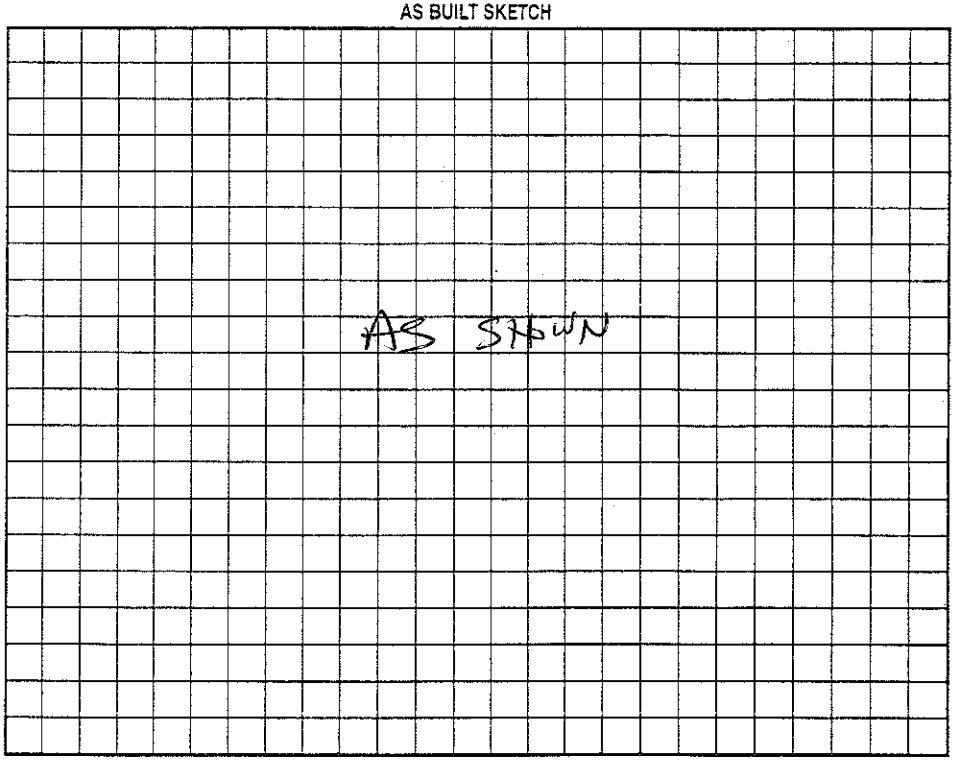

Permit can be suspended or revoked if any false information is supplied toward securing the permit/any unauthorized changes are made to the site/any unauthorized changes are made in the installation of the system. Improvement Permit with plat valid without expiration. Improvement Permit with site plan valid for sixty months. Authorization to Construct is valid for a period equal to that of Improvement Permit – not to exceed sixty months.

Signed: _____ date 11/1/04 Installed by: Rowan Septic

Improvement Permit by: _____ date 10-28-04 Operation Permit by: Steve Hedrick date 10-28-05

Authorization to Construct by: _____ date 10-28-04 Existing System Inspection by: _____ date _____

HEALTH DEPT. COPY: WHITE OWNER COPY (FINAL): YELLOW OWNER COPY (INITIAL): PINK