IREDELL COUNTY HEALTH DEPARTMENT

Statesville Office (704) 878-5305 Mooresville Office (704) 660-3625 PERMIT # 215025

IMPROVEMENT PERMIT / AUTHORIZATION TO CONSTRUCT / OPERATION PERMIT / EXISTING SYSTEM

PIN # 4722796371

APPLICANT: Michael Janssen APPLICANT ADDRESS: 112 Whistling Pines

SITE ADDRESS: 112 Whistling Pines PHONE: 704-775-9167 ALT. PHONE: N/A

SITE DIRECTIONS: Buffalo Shoals Rd to Davidson TR Winding Cedar TL Whistling Pine Property on Right

SUBDIVISION: Davidson Woods SECTION: 2 LOT # 35 LOT AREA: 6.459 DESIGN FLOW: Existing L.T.A.R.: Existing

Septic Tank	Existing (gal)	STB		Date			
Pump Tank	(gal)	PT		Date			
Pump Make		Model		Serial #			
# Nitrification Fields	6x	# Lines	6x	Linear Ft:	6x		
Trench Width	6x	Max. Trench Bottom Depth	6x	Gravel Depth	6x		

☐ New System ☐ Repair ☐ Expansion System Type: I II (III) IV V VI

System Description: Existing

Repair System Description:

Maintenance Agreement Required: ☐ YES ☑ NO

☑ GRAVITY ☐ PRESSURE

☑ Residence ☐ Business ☐ Other ☐ Slab ☐ Basement w/plumbing

No. Bedrooms 6x No. Persons 6x No. Employees ☑ Crawl Space

☐ Basement w/o plumbing


Water Supply: ☐ Private ☑ Public ☐ Community

Comments / Conditions:

Maintain a minimum of 5' between proposed bldg & all component of existing septic system as well as Repair Areas. Existing septic tank is partially under existing Deck as shown below.

INITIAL SITE SKETCH

AS BUILT SKETCH

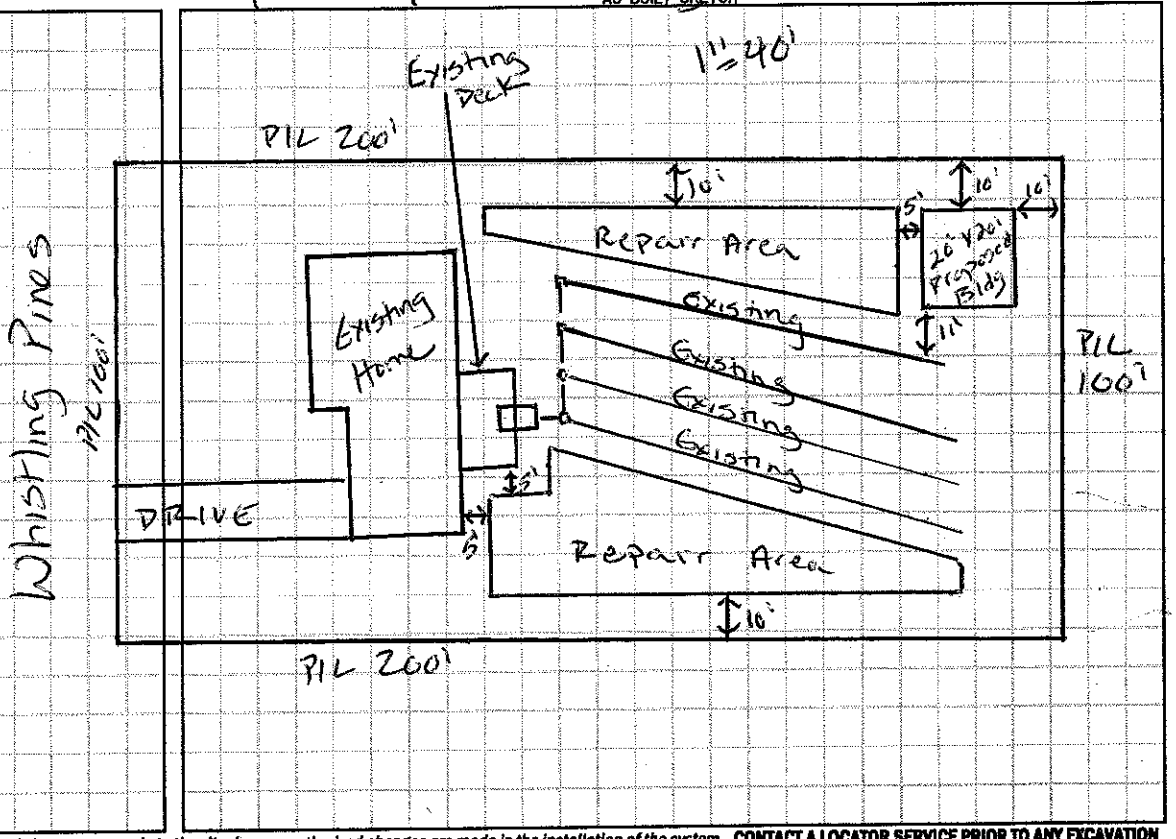

Permit can be suspended or revoked if any false information is supplied toward securing the permit / any unauthorized changes are made to the site / any unauthorized changes are made in the installation of the system. **CONTACT A LOCATOR SERVICE PRIOR TO ANY EXCAVATION**


☐ **IMPROVEMENT PERMIT** *with plat valid without expiration.* ☐ **IMPROVEMENT PERMIT** *with site plan valid for 60 mos.* ☐ **AUTHORIZATION TO CONSTRUCT** *valid for period equal to IMPROVEMENT PERMIT--not to exceed 60 mo.*

Owner / Applicant Signature: Bill Sheffield Date: 1/12/16 Installed by:

IMPROVEMENT PERMIT by: Date: OPERATION PERMIT by: Date:

AUTHORIZATION TO CONSTRUCT by: Date: Existing System Inspected by: Justin Henderson Date: 1-8-16

Health Dept. Copy - WHITE Applicant (Final Approval) - YELLOW Applicant (Conditional Approval) - PINK

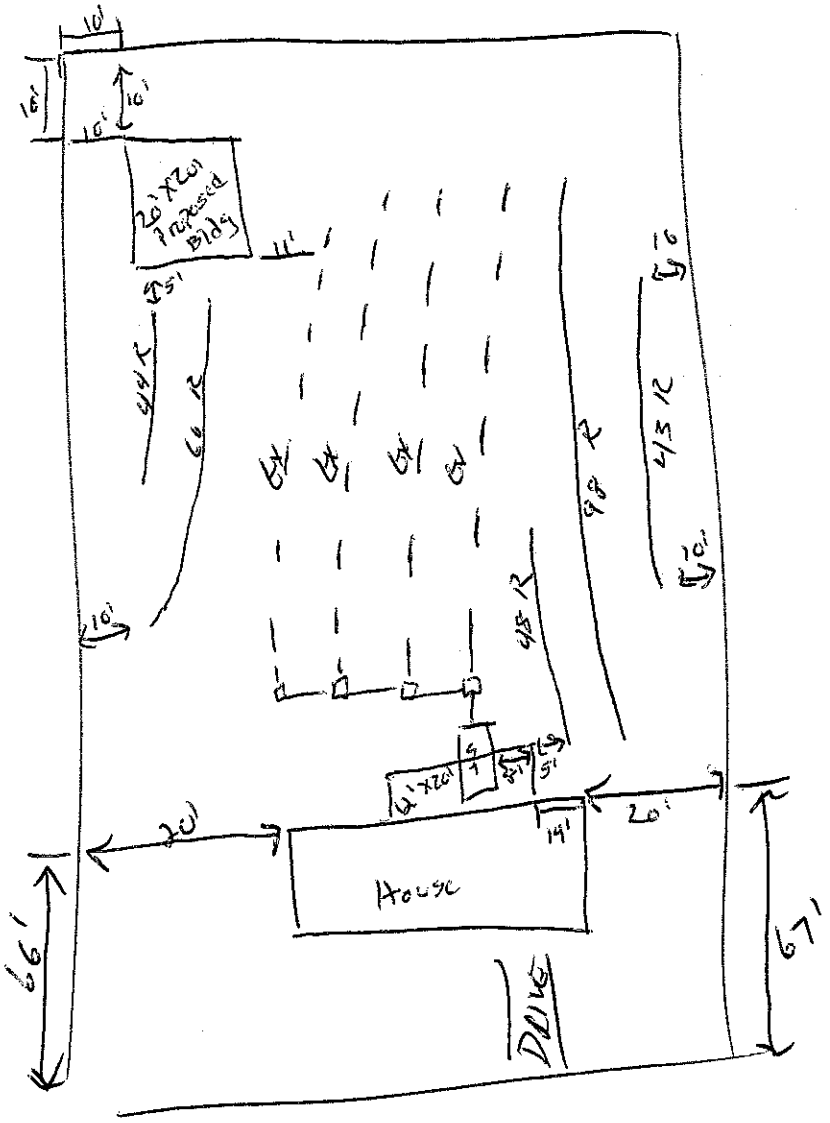
10'
16'
10'
10'
20'x20' Proposed Bldg
11'
5'
6/12
6/12
4/12
4/12
6/12
6/12
10'
10'
5'
5'
5'
12'x20'
20'
20'
14'
House
99'
67'
DRIVE

2d.