IREDELL COUNTY HEALTH DEPARTMENT

CI STATESVILLE 704-878-5305 130,10 Rid MOORESVILLE 704-664-5281

IMPROVEMENT PERMIT / AUTHORIZATION TO CONSTRUCT / OPERATION PERMIT / EXISTING SYSTEM INSPECTION

PERMIT# 119952 PIN# 4722-79-1840.22 2600 DATE July 29, 2004

OWNER OR CONTRACTOR Mountain Creek Inv. LLC / Spence Blades, PHONE: Business _____ Home _____

ADDRESS 117 Whaling Dr, Mooresville, NC 28117

LOCATION From Troutman - Old Mountain Rd TR Buffalo Shoals TR Davidson Rd. TR Winding Cedar x Creek on left NEAR top of hill.

SUBDIVISION Davidson Woods BLOCK / SECTION II LOT 22 LOT AREA .5 Ac SITE CLASS. PS DESIGN FLOW 360gpd L.T.A.R. .25-.3

Septic Tank: 1000 Gallons; STB 825 Date 7-10-04
Pump Tank: 1000 Gallons; PT 307 Date 6-22-04
Pump Make: Zoeller Model M-98 Serial No. _____
Nitrification Field: No Fields 1 Square Feet 1080 Linear Feet 360
No Lines 4 Trench Width 36" Max Trench Bottom Depth 36"

☑ New System ☐ Repair System Type: I, II, III, IV, V, VI
System Description: pm 25% Reduction
Repair System Description: LPPPBPS
Maintenance Agreement Required: ☐ Yes ☑ No initially
Gravel Depth NA


☑ House/Mod. Home No. Bedrooms 3
☐ Mobile Home No. Bathrooms 2
☐ Business No. Employees _____
☐ Other _____
☐ Slab ☑ Crawl Space ☐ Basement w/plumbing ☐ Basement wo/plumbing

Water Supply:
☐ Individual
☑ Public
☑ Community


Comments:/Conditions:
Pumpspecs: 36 gal/min @ 26' TDH
½" taps on pressure manifold

Comments:/Conditions: INSTALLED AS DRAWN
√'D LINES & TANKS & PRESSURE
POLYLOK FILTER & MARKER
NEED ELECTRICIAN & ALARM FIXED, LEFT NOTE

INITIAL SITE SKETCH

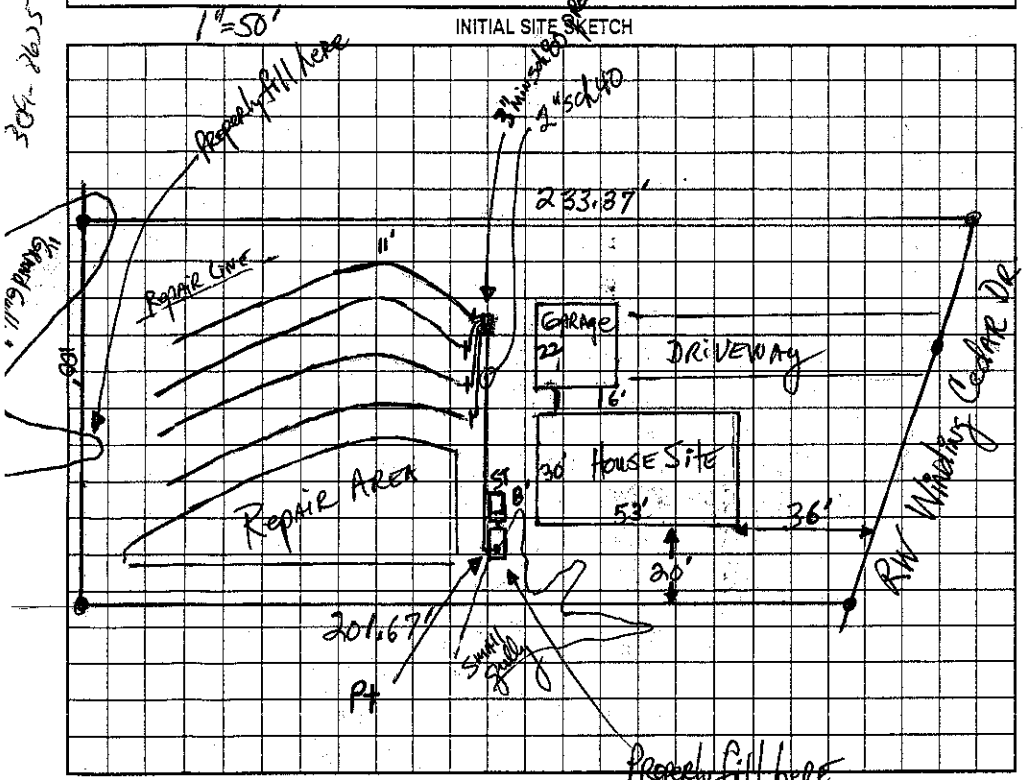

AS BUILT SKETCH

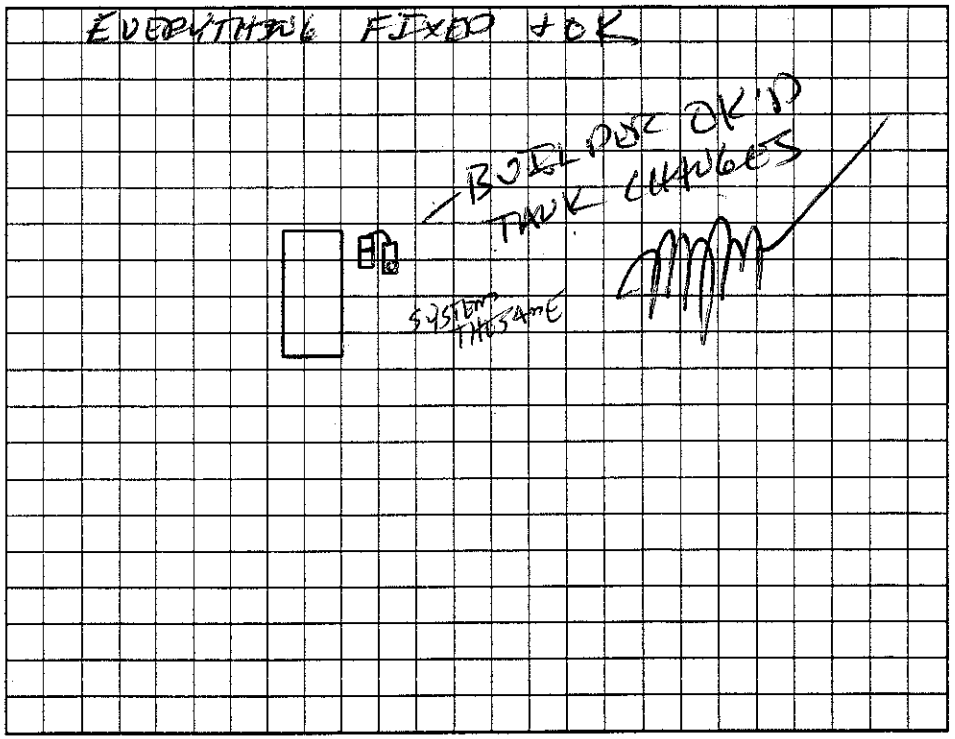

Permit can be suspended or revoked if any false information is supplied toward securing the permit/any unauthorized changes are made to the site/any unauthorized changes are made in the installation of the system. Improvement Permit with plat valid without expiration. Improvement Permit with site plan valid for sixty months. Authorization to Construct is valid for a period equal to that of Improvement Permit – not to exceed sixty months.

Signed: _____ date 7-30-04 Installed by: ROWAN SEPTIC

Improvement Permit by: _____ date 7-29-04 Operation Permit by: _____ date 11-22-04

Authorization to Construct by: _____ date 7-29-04 Existing System Inspection by: _____ date _____

HEALTH DEPT. COPY: WHITE OWNER COPY (FINAL): YELLOW OWNER COPY (INITIAL): PINK