C1

# IREDELL COUNTY HEALTH DEPARTMENT

STATESVILLE 704-878-5305 MOORESVILLE 704-664-5281

## IMPROVEMENT PERMIT / AUTHORIZATION TO CONSTRUCT / OPERATION PERMIT / EXISTING SYSTEM INSPECTION

PERMIT# 136759 PIN# 4772-79-2937 DATE 07/19/06

OWNER OR APPLICANT MTN. CREEK INVESTMENTS PHONE: Business 704-506-0207 Home

ADDRESS 2350 CLYDE RD, CATAWBA, NC 28609

LOCATION BUFFALO SHOALS RD. SOUTH, (L) DAVIDSON RD., (R) WINDING CEDAR DR., LOT ON RIGHT,

SUBDIVISION DAVIDSON WOODS BLOCK / SECTION LOT 41 LOT AREA 2.536 AC. SITE CLASS PS DESIGN FLOW 360 GPD L.T.A.R. 0.30 GPD/FT²

Septic Tank: 1,000 Gallons; STB 825 Date 9-27-06
Pump Tank: 1,000 Gallons; PT 302 Date 10-12-06
Pump Make: ZOELLAR Model N152 Serial No.
Nitrification Field: No Fields 1 Square Feet EQ to 1,200 Linear Feet 200'
No Lines 3 Trench Width 24" Max Trench Bottom Depth 36"

☒ New System ☐ Repair ☐ Expansion System Type: I II III (IV) V VI
System Description: 50% REDUCTION, LOW PRESSURE
Repair System Description: 50% REDUC., LOW PRESSURE
Maintenance Agreement Required: ☒ Yes ☐ No

☒ House/Mod. Home No. Bedrooms 3
☐ Mobile Home No. Persons
☐ Business No. Employees
☐ Other


Water Supply: ☐ Individual ☒ Public ☐ Community

Gravel Depth N/A ☐ Gravity ☒ Pressure ☐ Slab ☐ Crawl Space ☒ Basement w/plumbing ☐ Basement wo/plumbing

Comments:/Conditions: (1) SEE ATTACHED PUMP AND LOW PRESSURE PANEL INFO. SHEETS, (2) DO NOT RUN SUPPLY LINE THROUGH REPAIR AREA SHOWN. (3) USE 46 PANELS TO INSTALL.

Comments:/Conditions: SYSTEM INSTALLED ACCORDING TO INITIAL SITE SKETCH

INITIAL SITE SKETCH

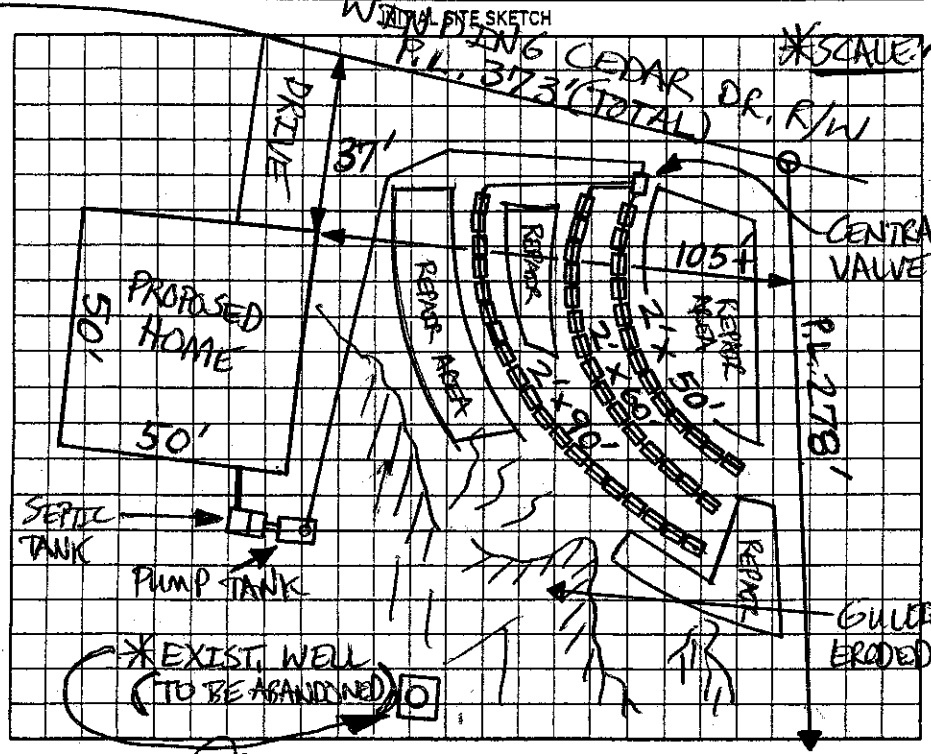


AS BUILT SKETCH

Permit can be suspended or revoked if any false information is supplied toward securing the permit/any unauthorized changes are made to the site/any unauthorized changes are made in the installation of the system. Improvement Permit with plat valid without expiration ☐ Improvement Permit with site plan valid for sixty months ☒ Authorization to Construct is valid for a period equal to that of Improvement Permit – not to exceed sixty months.

Signed: date 8/31/06 Installed by: Rowan Septic

Improvement Permit by: date 07/19/06 Operation Permit by: , R.S. date 20 December 06

Authorization to Construct by: date 08/31/06 Existing System Inspection by: date

HEALTH DEPT. COPY: WHITE OWNER COPY (FINAL): YELLOW OWNER COPY (INITIAL): PINK