IREDELL COUNTY HEALTH DEPARTMENT

STATESVILLE 704-878-5305 MOORESVILLE 704-664-5281

IMPROVEMENT PERMIT / AUTHORIZATION TO CONSTRUCT / OPERATION PERMIT / EXISTING SYSTEM INSPECTION

PERMIT# 119974 PIN# ~~4720~~ ~~4772~~ 4722793111 DATE 3-27-06

OWNER OR APPLICANT Paul Combs PHONE: Business 704-902-4785 Home

ADDRESS 132-2 South Main St Mooresville 28115

LOCATION I-40 W OMK TL Buffalo Shoals TL Davidson Woods TR Winding Cedar TR Short Pine TL At End

SUBDIVISION DAVIDSON WOODS BLOCK / SECTION 2 LOT 32 LOT AREA 48 SITE CLASS. PS DESIGN FLOW 360 L.T.A.R. .125

Septic Tank: 1000 Gallons; STB Date
Pump Tank: Gallons; PT Date
Pump Make: Model Serial No.
Nitrification Field: No Fields Square Feet 1440 Linear Feet 360
No Lines 7 Trench Width 36 Max Trench Bottom Depth 36"

☑ New System ☐ Repair ☐ Expansion System Type: I II III IV V VI
System Description: 25% Gravity
Repair System Description: LP Panel
Maintenance Agreement Required: ☐ Yes ☑ No
Gravel Depth ☑ Gravity ☐ Pressure


☑ House/Mod. Home ☐ Mobile Home ☐ Business ☐ Other
No. Bedrooms 3 No. Persons No. Employees
☐ Slab ☐ Crawl Space ☐ Basement w/plumbing ☐ Basement wo/plumbing

Water Supply: ☐ Individual ☑ Public ☐ Community

Comments:/Conditions:

Comments:/Conditions:
360' 25% Reduction
Install on Contour
Maintain all setbacks

INITIAL SITE SKETCH

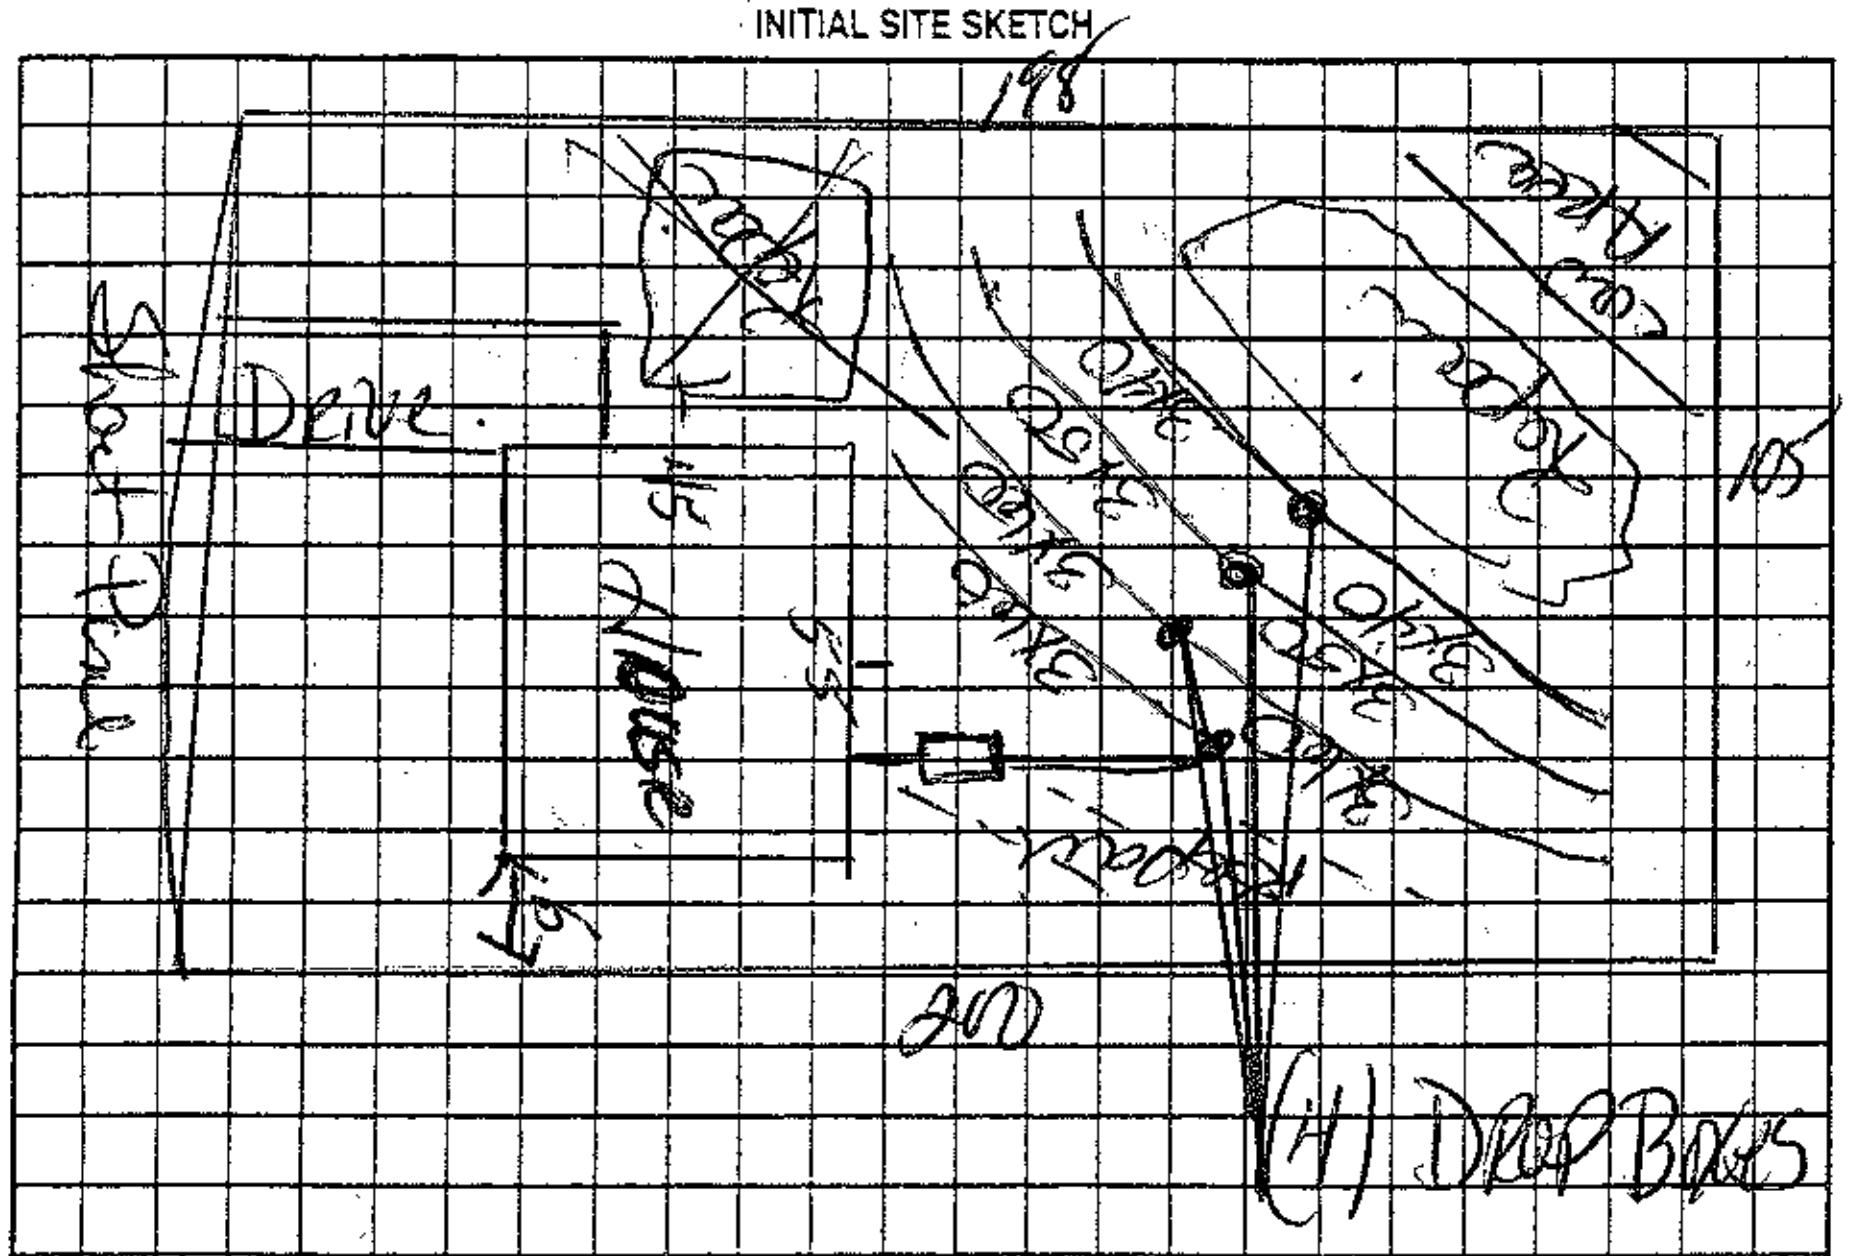

AS BUILT SKETCH

Red Poly lock
Septic tank marker

Permit can be suspended or revoked if any false information is supplied toward securing the permit/any unauthorized changes are made to the site/any unauthorized changes are made in the installation of the system. Improvement Permit with plat valid without expiration ☐ Improvement Permit with site plan valid for sixty months ☐ Authorization to Construct is valid for a period equal to that of Improvement Permit – not to exceed sixty months.

Signed: X Santiago Lopez date 3-27-06
Improvement Permit by: [signature] date 3-27-06
Authorization to Construct by: [signature] date 3-27-06
Installed by: Scott Green
Operation Permit by: [signature] date 2-12-07
Existing System Inspection by: date

HEALTH DEPT. COPY: WHITE OWNER COPY (FINAL): YELLOW OWNER COPY (INITIAL): PINK