IREDELL COUNTY HEALTH DEPARTMENT

VIUM (C) 130.00 Paid

STATESVILLE 704-878-5305 MOORESVILLE 704-664-5281

IMPROVEMENT PERMIT / AUTHORIZATION TO CONSTRUCT / OPERATION PERMIT / EXISTING SYSTEM INSPECTION

PERMIT# 111584 PIN# ~~4723-70-1483.15~~ 4722-79-6918 DATE Nov. 13, 03

OWNER OR CONTRACTOR Mtn. Creek Inv. // Spear Builders PHONE: Business _____ Home _____

ADDRESS 117 Whaling Dr., Mooresville, N.C. 28117

LOCATION From Troutman Old Mtn. Rd. TR, Buffalo Shoals (N.) TR Davidson Rd. TR Winding Cedar SFE 15A - 1st on Right; Lot 15 ~800' on Left

SUBDIVISION Davidson Woods BLOCK / SECTION _____ LOT 15/15A LOT AREA .46AC +.24AC SFE SITE CLASS. PS SFE 15A DESIGN FLOW 360gpd L.T.A.R. .25 SFE 15A

Septic Tank: 1000 Gallons; STB 825 Date 11-24-03
Pump Tank: 1000 Gallons; PT 362 Date 5-9-03
Pump Make: Zoeller Model E191 Serial No. 191-0004
Nitrification Field: No Fields 1 Square Feet 1080 Linear Feet 360
No Lines 5 Trench Width 36" Max Trench Bottom Depth 36"


☑ New System ☐ Repair System Type: I, II, III, IV, V, VI
System Description: PS 25% Reduction on SFE 15A
Repair System Description: LPPPBPS on SFE 15A
Maintenance Agreement Required: ☐ Yes ☑ No initially
Gravel Depth NA ☐ Slab ☑ Crawl Space ☐ Basement w/plumbing ☐ Basement wo/plumbing

☑ House/Mod. Home No. Bedrooms 3
☐ Mobile Home No. Bathrooms 2
☐ Business No. Employees _____
☐ Other _____

Water Supply: ☐ Individual ☑ Public ☑ Community

Comments:/Conditions: 10' minimum must be maintained between WW supply lines and parallel potable water line. Any crossing of these lines must be done in accordance w/ .1950 "F"


INITIAL SITE SKETCH

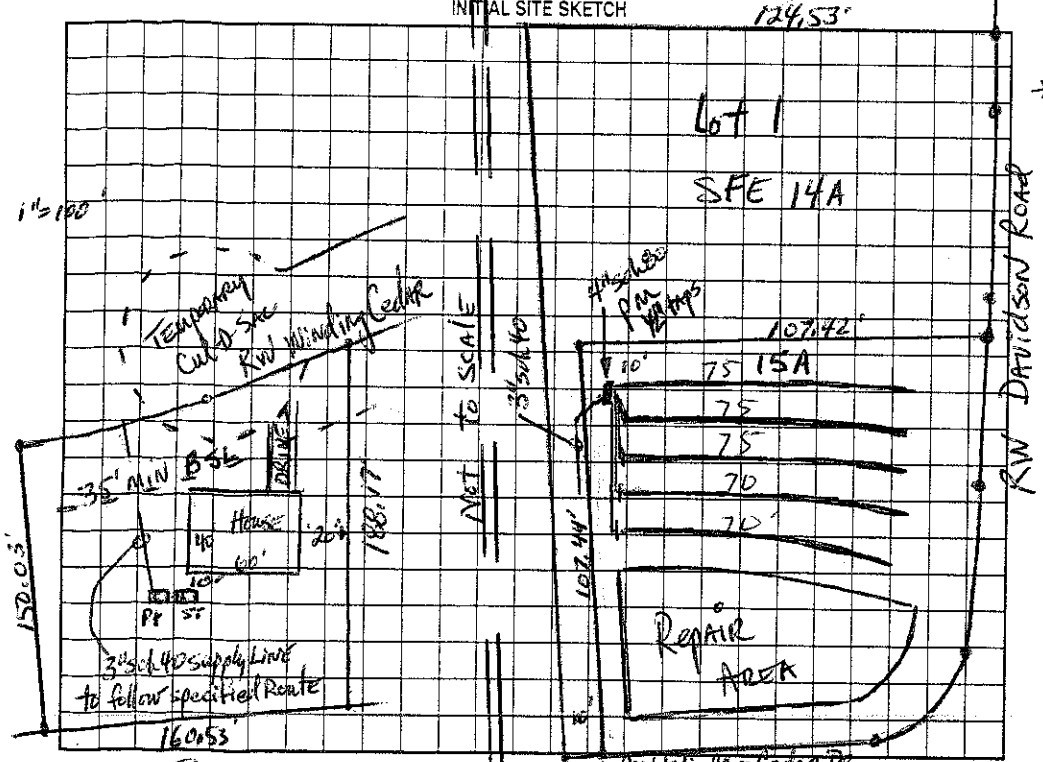

Comments:/Conditions: POLYLOK FILTER & MARKER

* V'D LINES & SET PRESSURE. PRESSURE NOT APPROVED. NO EASEMENT FROM THE STATE & DISTANCE FROM SUPPLY LINE & H2O LINE NOT KNOWN. LC 1-23-04 LC

AS BUILT SKETCH

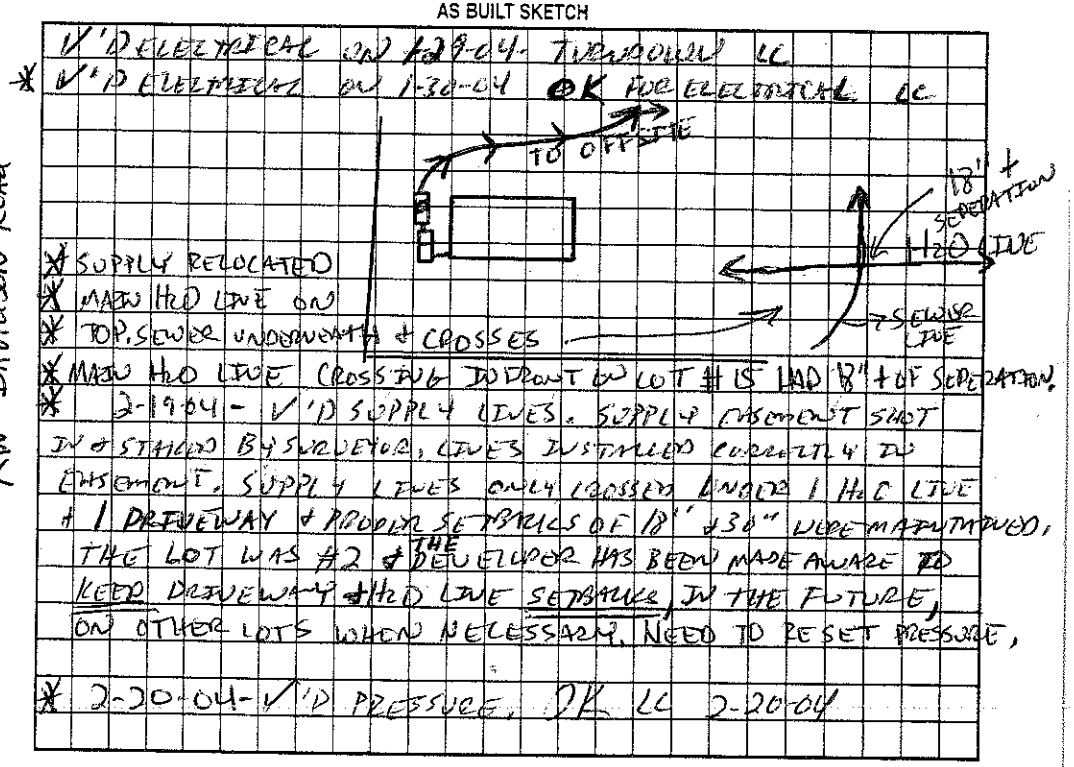

Permit can be suspended or revoked if any false information is supplied toward securing the permit/any unauthorized changes are made to the site/any unauthorized changes are made in the installation of the system. Improvement Permit with plat valid without expiration. Improvement Permit with site plan valid for sixty months. Authorization to Construct is valid for a period equal to that of Improvement Permit – not to exceed sixty months.

Signed: _____ date _____ Installed by: ROWAN SEPTIC

Improvement Permit by: _____, RS date 11-13-03 Operation Permit by: _____ date 2-20-04

Authorization to Construct by: _____, RS date 11-13-03 Existing System Inspection by: _____ date _____

HEALTH DEPT. COPY: WHITE OWNER COPY (FINAL): YELLOW OWNER COPY (INITIAL): PINK