44786

IREDELL COUNTY HEALTH DEPARTMENT

STATESVILLE 704-878-5305 MOORESVILLE 704-664-5281

IMPROVEMENT PERMIT / CERTIFICATE OF COMPLETION / OPERATION PERMIT / EXISTING SYSTEM INSPECTION

PROPERTY DESCRIPTION NO. 14635 DATE 7-16-93 TAX MAP NO. 3K-B-40

OWNER OR CONTRACTOR Ronnie Crouch PHONE: Business Home

ADDRESS

LOCATION I-40 W TL Old Mtn. Rd. TR Trautman Farm Rd. TL paved drive on L, Lot off Rd back in Woods.

SUBDIVISION N/A BLOCK / SECTION LOT LOT AREA SITE CLASS. P.S. L.T.A.R. .4 gpd/ft²

Water Supply: ☑ Individual ☐ Community ☐ Public Well shared with garage

Septic Tank: 1000 Gallons; STB 1012 Date 5-8-93

Pump Tank: — Gallons; PT — Date —

Nitrification Field: No Fields 1 Square Feet 900 Linear Feet 300'

No Lines 3 Trench Width 36" Trench Depth 24"-36" Gravel Depth 12"

☑ New System ☐ Repair System Type: I. II. III. IV. V. VI

System Description: Conventional, gravity

Repair System Description: " "

Maintenance Agreement Required: ☐ Yes ☑ No

☑ House/Mod. Home ☐ Mobile Home ☐ Business ☐ Other

No. Bedrooms 3 No. Bathrooms 2 No. Employees —

☐ Slab ☐ Crawl Space ☑ Basement w/plumbing ☐ Basement wo/plumbing

Garbage Disposal: ☐ Yes ☑ No

Auto. Dishwasher: ☑ Yes ☐ No


Auto. Washing Machine: ☑ Yes ☐ No

Other

Comments Keep well min. 100' from septic system and repair Area. 100% Repair Area beside system, conventional, gravity fed.

INITIAL SITE SKETCH

AS BUILT SKETCH

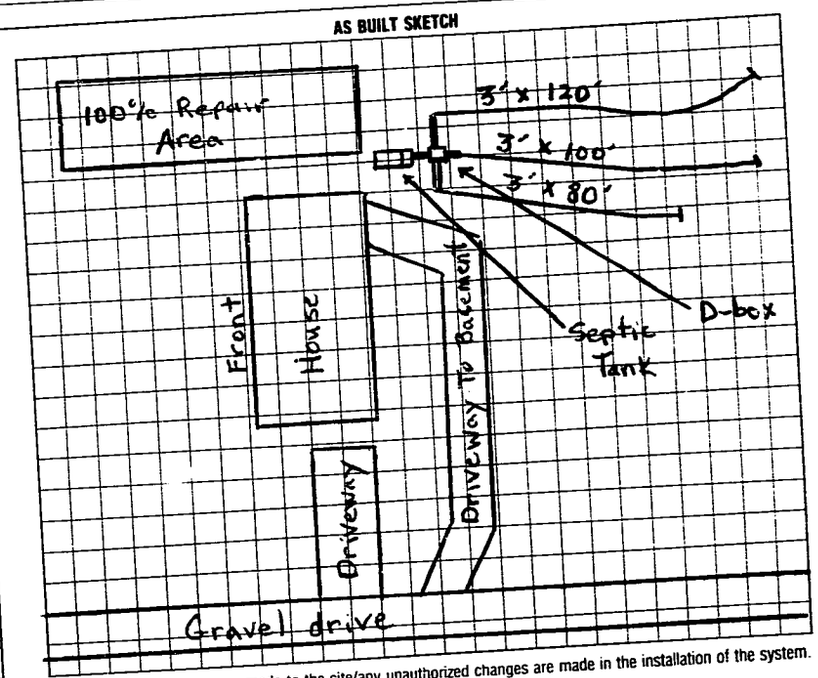

3.5

I understand that this permit can be suspended or revoked if any false information is supplied toward securing the permit/any unauthorized changes are made to the site/any unauthorized changes are made in the installation of the system. Improvement Permit is valid for 60 months from date of issuance.

Signed:

Improvement Permit by: Steve Brown date 5-27-92

Existing System Inspection by: date

Installed by: James Hudler

Certificate of Completion by: Michael J. Dennis date 7-16-93

Operation Permit by: date

HEALTH DEPT. COPY: WHITE INSPECTION COPY (FINAL): GREEN OWNER COPY (FINAL): YELLOW INSPECTION COPY (INITIAL): PINK OWNER COPY (INITIAL): GOLD