THE FINISHED TOUCH

IREDELL COUNTY HEALTH DEPARTMENT

STATESVILLE 704-878-5305 MOORESVILLE 704-664-5281

IMPROVEMENT PERMIT / AUTHORIZATION TO CONSTRUCT / OPERATION PERMIT / EXISTING SYSTEM INSPECTION

(11)

PERMIT# 145547 PIN# 4722-82-1625 DATE 10-18-07

OWNER OR APPLICANT KENNETH WORKMAN PHONE: Business 704-872-0573 Home

ADDRESS 211 TROUTMAN FARM ROAD STATESVILLE NC 28677

LOCATION OLD MOUNTAIN ROAD TO TROUTMAN FARM ROAD, 0.5 MILE ON LEFT AT #211

SUBDIVISION BLOCK / SECTION LOT LOT AREA 3.02 ACRES SITE CLASS. PS DESIGN FLOW 480 L.T.A.R. 0.25 GAD/FT²

Septic Tank: EXISTING Gallons: STB Date

Pump Tank: Gallons: PT Date

Pump Make: Model EQUIP Serial No.

Nitrification Field: No Fields 1 Square Feet 480 Linear Feet 120

No Lines TWO Trench Width 36" Max Trench Bottom Depth 24" Gravel Depth N/A

☒ New System ☐ Repair ☐ Expansion System Type: I (II) III IV V VI

System Description: 25% REDUCTION GRAVITY

Repair System Description: 25% REDUCTION, GRAVITY

Maintenance Agreement Required: ☐ Yes ☒ No

☒ Gravity ☐ Pressure

☒ House/Mod. Home No. Bedrooms 4

☐ Mobile Home No. Persons

☐ Business No. Employees

☐ Other

Water Supply: ☒ Individual ☐ Public ☐ Community WELL


☐ Slab ☒ Crawl Space ☐ Basement w/plumbing ☐ Basement wo/plumbing

Comments:/Conditions: (1) INSTALL NEW SANITARY TEE IN TANK & NEW DISTRIBUTION BOX IF NECESSARY (2) INSTALL TWO NEW 3'x60' DRAINLINES USING 25% REDUCTION SYSTEM ON CONTOUR NO DEEPER THAN 24".


Comments:/Conditions:

~SCALE: 1" = 60'

INITIAL SITE SKETCH

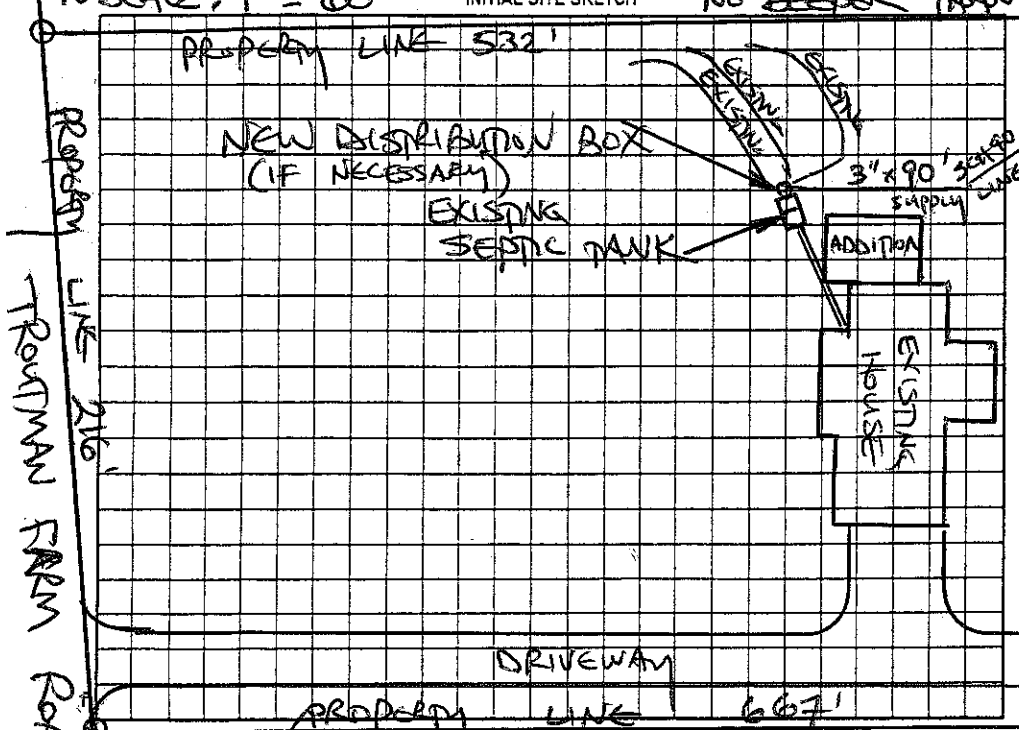

AS BUILT SKETCH

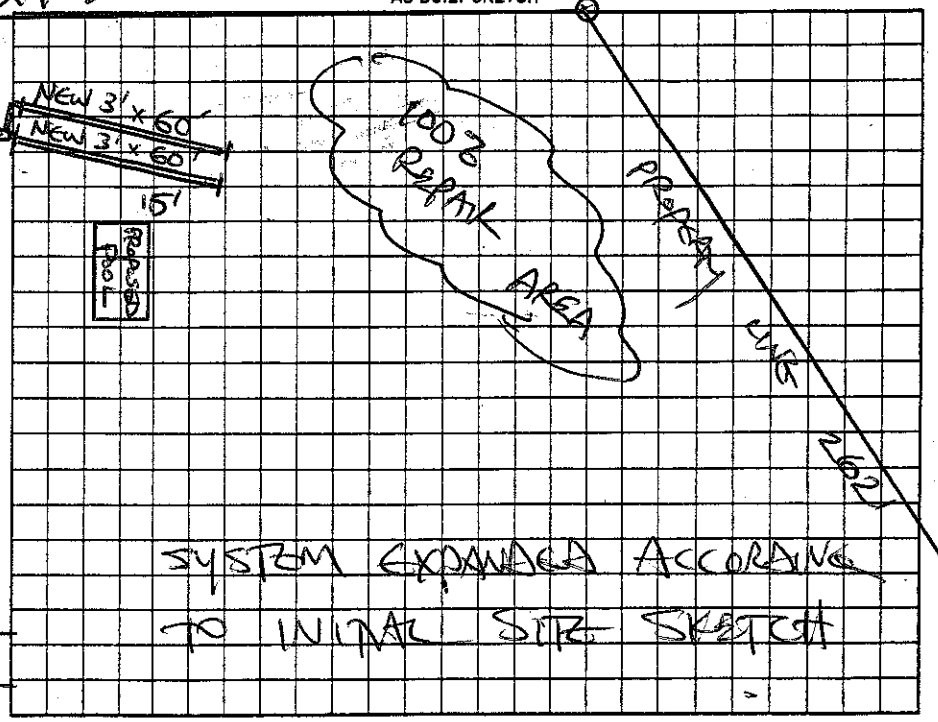

SYSTEM EXPANDED ACCORDING TO INITAL SITE SKETCH

Permit can be suspended or revoked if any false information is supplied toward securing the permit/any unauthorized changes are made to the site/any unauthorized changes are made in the installation of the system. Improvement Permit with plat valid without expiration ☑ Improvement Permit with site plan valid for sixty months ☒ Authorization to Construct is valid for a period equal to that of Improvement Permit – not to exceed sixty months.

Signed: Wanda Myers date 10-18-07 Installed by: STEVE JORDAN

Improvement Permit by: STEVE HENDRICK date 10-18-07 Operation Permit by: STEVE HENDRICK date 12-20-07

Authorization to Construct by: STEVE HENDRICK date 10-18-07 Existing System Inspection by: date

HEALTH DEPT. COPY: WHITE OWNER COPY (FINAL): YELLOW OWNER COPY (INITIAL): PINK