IREDELL COUNTY HEALTH DEPARTMENT

STATESVILLE 704-878-5305 MOORESVILLE 704-664-5281

IMPROVEMENT PERMIT / AUTHORIZATION TO CONSTRUCT / OPERATION PERMIT / EXISTING SYSTEM INSPECTION

PERMIT# Farm Use PIN# DATE 5/29/01

OWNER OR CONTRACTOR David Trantman PHONE: Business Home (704) 528-5981

ADDRESS 197 Trantman Farm Road Statesville N.C. 28677

LOCATION HWY 21 S., (R) on Mt. Ply (L) Trantman Farm Road 4 mile to Farm on Right

SUBDIVISION — BLOCK / SECTION — LOT — LOT AREA Acres SITE CLASS IS DESIGN FLOW 100 L.T.A.R. .25

Septic Tank: 1000 Gallons: STB 760 Date 3-2-01

Pump Tank: Gallons: PT Date

Pump Make: Model Serial No

Nitrification Field: No Fields 1 Square Feet 700 Linear Feet 134

No Lines 20.67 Trench Width 36" Max Trench Bottom Depth 30" Gravel Depth 12"

[X] New System [ ] Repair System Type: I (II) III, IV, V, VI

System Description: Gravity Conventional

Repair System Description: Gravity Conventional

Maintenance Agreement Required: [ ] Yes [X] No

[ ] Slab [ ] Crawl Space [ ] Basement w/plumbing [ ] Basement wo/plumbing

[ ] House/Mod. Home [ ] Mobile Home [ ] Business [X] Other Dairy Farm


No. Bedrooms — No. Bathrooms — No. Employees 1

Water Supply: [X] Individual [ ] Public [ ] Community

Comments/Conditions: Install lines on Contour ② keep area over drainfield is pasture (grass), limit traffic if needed.

Comments/Conditions: SEPTIC TANK WITH MARKER INSTALLED USING ~~[illegible]~~ FILTER "ZABEL"

INITIAL SITE SKETCH (Not to Scale)

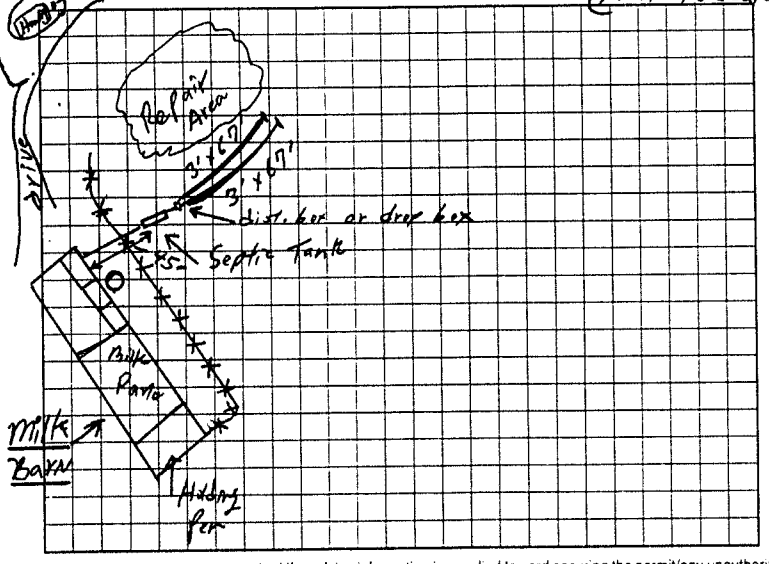

AS BUILT SKETCH

SYSTEM INSTALLED ACCORDING TO INITIAL SITE SKETCH

Permit can be suspended or revoked if any false information is supplied toward securing the permit/any unauthorized changes are made to the site/any unauthorized changes are made in the installation of the system. Improvement Permit with plat valid without expiration. Improvement Permit with site plan valid for sixty months. Authorization to Construct is valid for a period equal to that of Improvement Permit – not to exceed sixty months.

Signed: X David K Trantman date

Improvement Permit by: William O. Johnson IRSI date 5/29/01

Authorization to Construct by: William O. Johnson IRSI date 5/29/01

Installed by: BARRY SIGMON

Operation Permit by: STEVE HEDRICK date 6-28-01

Existing System Inspection by: date

HEALTH DEPT. COPY WHITE OWNER COPY (FINAL) YELLOW OWNER COPY (INITIAL) PINK