IREDELL COUNTY HEALTH DEPARTMENT

(SEPTIC TANK) IMPROVEMENTS PERMIT AND CERTIFICATE OF COMPLETION
(Ground Absorption Sewage Disposal System -- G. S. Chapter 130-Article 13C)

OWNER OR CONTRACTOR FLOYD CARVER DATE 4-9-90 PERMIT NO. _____

PHONE: Business _____ Home _____

LOCATION Hwy 115 Pt. south of Fork Xing - 2 approx. 1.25 miles on left, across from J & M Landfill.

SUBDIVISION NAME _____ LOT NO. _____ S. R. No. _____

SECTION OR BLOCK NO. _____

House (✓) Mobile Home ( ) Business ( ) Other Repair


No. Bedrooms _____ No. Bathrooms _____

Garbage Disposal Unit	Yes ( )	No ( )
Auto. Dishwasher	Yes ( )	No ( )
Auto. Wash. Machine	Yes ( )	No ( )
Site Suitable	Yes (✓)	No ( )

Lot Area Ample.

Character & Porosity of Soil _____
Percolation Rate _____
Topography _____
Depth to Water Table Repair
Rock or other impervious formations _____

_____ Basement with Plumbing ✓ Basement without Plumbing _____ No Basement

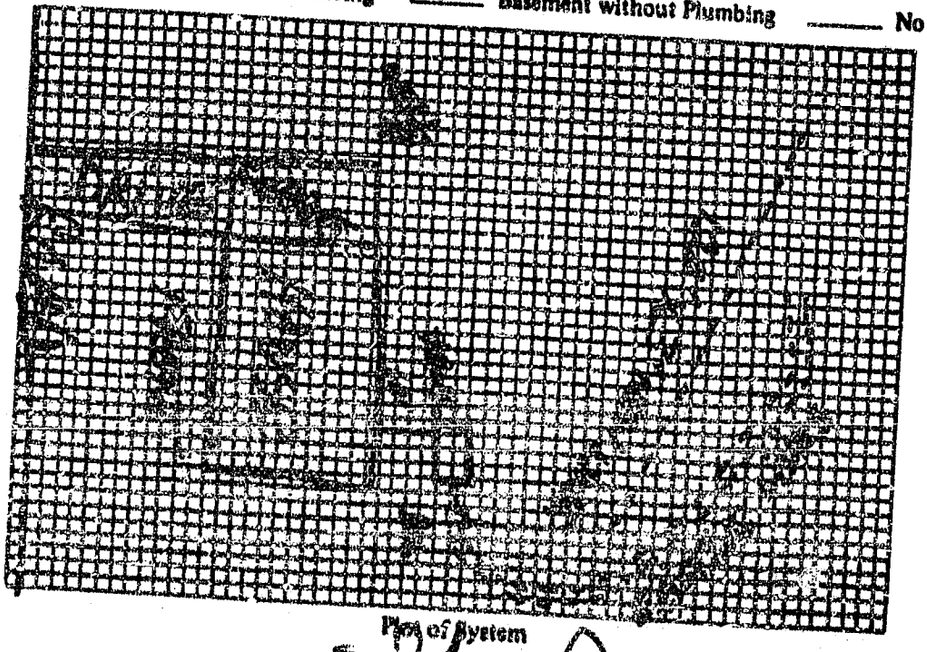

Plan of System

Size of Tank EXISTING Gals.
Nitrification Field:
No. of Lines 1
Sq. Ft. 360 Linear Ft. 120
Depth of Stone in Lines 12"
Water Supply: Individual (✓)
Public ( )

Installed by Wes Lytton

I understand and agree to install septic tank system as specified on this Improvements Permit.

Signed: _____

IMPROVEMENTS PERMIT BY Robert Brown

COMMENTS: _____

CERTIFICATE OF COMPLETION BY Robert Brown

EXISTING SYSTEM CHECKED BY: _____ DATE 4-9-90

CONSTRUCTION MUST COMPLY WITH ALL OTHER APPLICABLE STATE AND LOCAL REGULATIONS. DATE _____

Permit is VOID if any unauthorized changes are made in installation of system and/or if any false information is supplied in making Improvements Permit.

Health Dept. Copy: White Inspection Dept. Copy: Yellow Sanitarian's Copy: Pink Owner's Copy: Gold