IREDELL COUNTY HEALTH DEPARTMENT

STATESVILLE 704-878-5305 CI MOORESVILLE 704-664-5281

IMPROVEMENT PERMIT / AUTHORIZATION TO CONSTRUCT / OPERATION PERMIT / EXISTING SYSTEM INSPECTION

CJ

PERMIT# 110517 PIN# 4922-85-~~62-8446~~ 6415 DATE 12/31/02

OWNER OR CONTRACTOR David Trautman PHONE: Business — Home (704) 528-3952

ADDRESS 568 Pineville Rd Statesville NC 28677

LOCATION 21 South (R) on Old Mocksville, go past Wallace Springs Rd - 3rd House on Right new modular behind 582 old mfg. home

SUBDIVISION — BLOCK / SECTION — LOT — LOT AREA 1.528 Ac. SITE CLASS. PS DESIGN FLOW 360 L.T.A.R. .33

Septic Tank: 1000 Gallons; STB 354 Date 1-10-02
Pump Tank: _____ Gallons; PT _____ Date _____
Pump Make: _____ Model _____ Serial No. _____
Nitrification Field: No Fields 1 Square Feet 1029 Linear Feet 345
No Lines 3 Trench Width 36" Max Trench Bottom Depth 36" Gravel Depth 12"

[X] New System [ ] Repair System Type: I, II, III, IV, V, VI
System Description: Gravity Conv.
Repair System Description: Gravity, 50% Reduction
Maintenance Agreement Required: [ ] Yes [X] No


[X] House/Mod. Home No. Bedrooms 3
[ ] Mobile Home No. Bathrooms 2
[ ] Business No. Employees ____
[ ] Other _____
[ ] Slab [X] Crawl Space [ ] Basement w/plumbing [ ] Basement wo/plumbing

Water Supply: [X] Individual [ ] Public [ ] Community


Comments/Conditions: (1) Well must be 100 ft from Septic System because of Soil/site conditions (2) Maintain proper setbacks (3) Install lines on contour

Comments/Conditions: ST Marker + Poly Lot Filter Installed

INITIAL SITE SKETCH

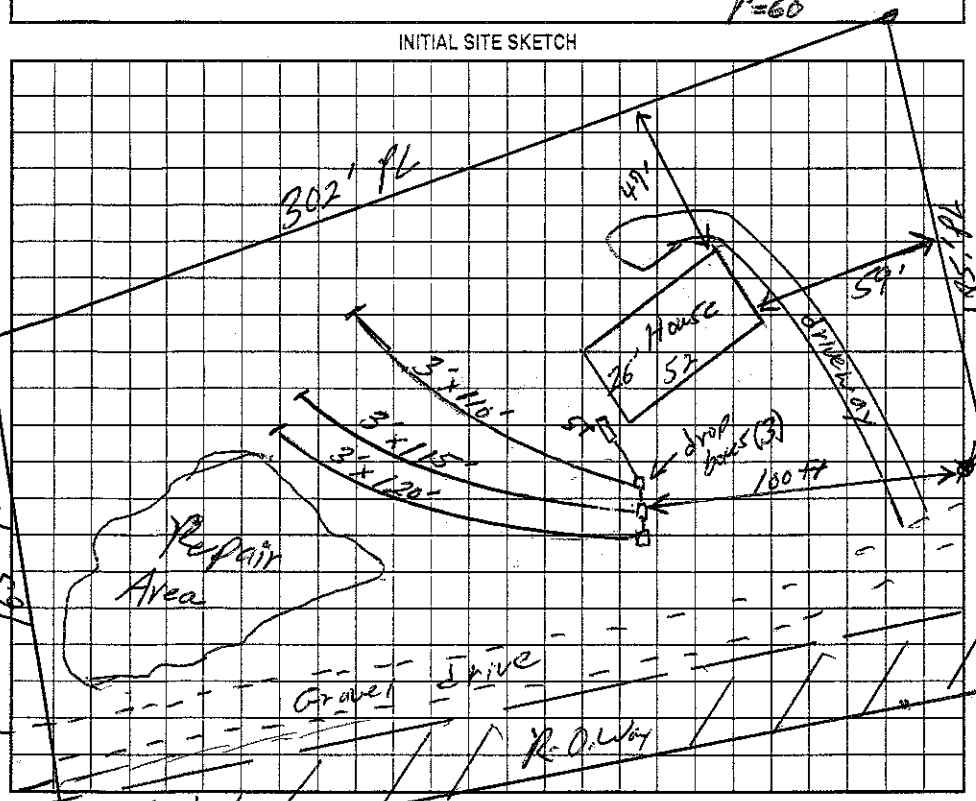

AS BUILT SKETCH

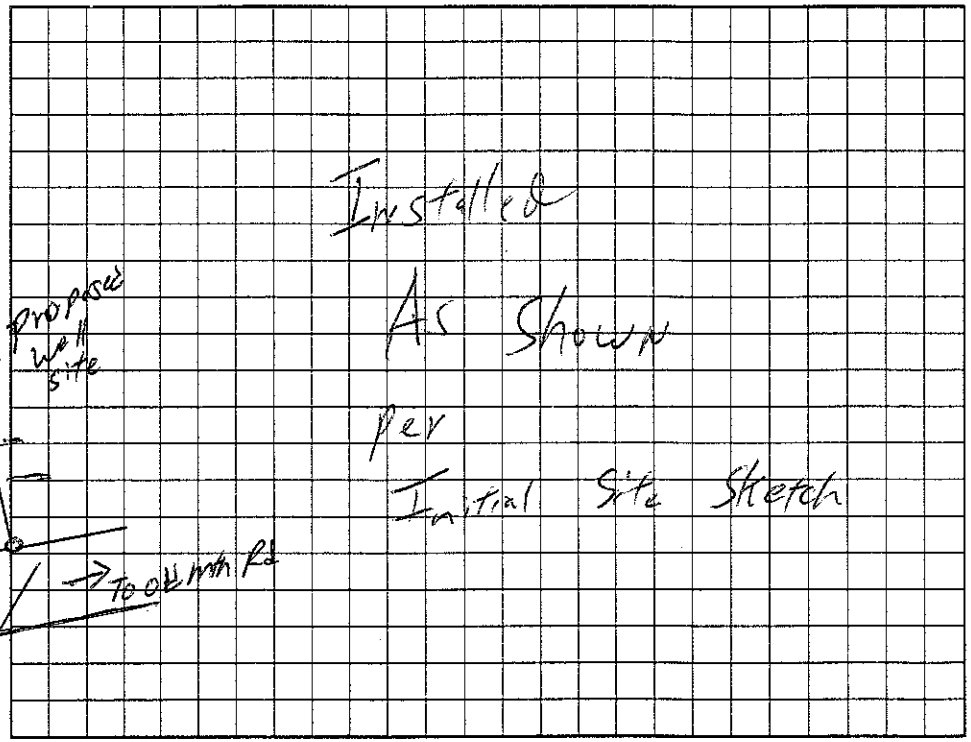

Permit can be suspended or revoked if any false information is supplied toward securing the permit/any unauthorized changes are made to the site/any unauthorized changes are made in the installation of the system. Improvement Permit with plat valid without expiration. Improvement Permit with site plan valid for sixty months. Authorization to Construct is valid for a period equal to that of Improvement Permit – not to exceed sixty months.

Signed: _____ date 1/13/03 Installed by: G + M Enterprise

Improvement Permit by: William O. Johnson date 12/31/02 Operation Permit by: William O. Johnson date 1/13/03

Authorization to Construct by: William O. Johnson date 12/31/02 Existing System Inspection by: _____ date _____

HEALTH DEPT. COPY: WHITE OWNER COPY (FINAL): YELLOW OWNER COPY (INITIAL): PINK