IREDELL COUNTY HEALTH DEPARTMENT

Statesville Office (704) 878-5305 Mooresville Office (704) 660-3625 PERMIT # 218058

IMPROVEMENT PERMIT / AUTHORIZATION TO CONSTRUCT / OPERATION PERMIT / EXISTING SYSTEM

PIN # 4722857859 ✓

APPLICANT: Gilbert Alfred APPLICANT ADDRESS: 151 Shalom Place

PHONE: 704-807-3037 ALT. PHONE: N/A

SITE ADDRESS: 151 Shalom Place

SITE DIRECTIONS: Wallace Springs Rd to Charis TL Shalom Place, Property @ end.

SUBDIVISION: Williams Farm SECTION: P2 LOT # 15 LOT AREA: 4.5 acres DESIGN FLOW: Existing L.T.A.R.: Existing

Septic Tank	Existing (gal)	STB	Date	☐ New System	☐ Repair	☐ Expansion	System Type: I ☒ II III IV V VI
Pump Tank	(gal)	PT	Date	System Description:	Existing		
Pump Make	Model		Serial #	Repair System Description:			
# Nitrification Fields	Ex # Lines	Ex	Linear Ft: Ex	Maintenance Agreement Required:	☐ YES	☒ NO	
Trench Width	Ex Max. Trench Bottom Depth	Ex	Gravel Depth Ex		☒ GRAVITY	☐ PRESSURE	

☒ Residence ☐ Business ☐ Other ☐ Slab ☒ Basement w/plumbing

No. Bedrooms Ex No. Persons Ex No. Employees ☐ Crawl Space


☐ Basement w/o plumbing

Water Supply: ☒ Private ☐ Public ☐ Community


Comments / Conditions:

- Maintain a minimum of 5' between proposed deck foundation & all components of septic tank system.

INITIAL SITE SKETCH

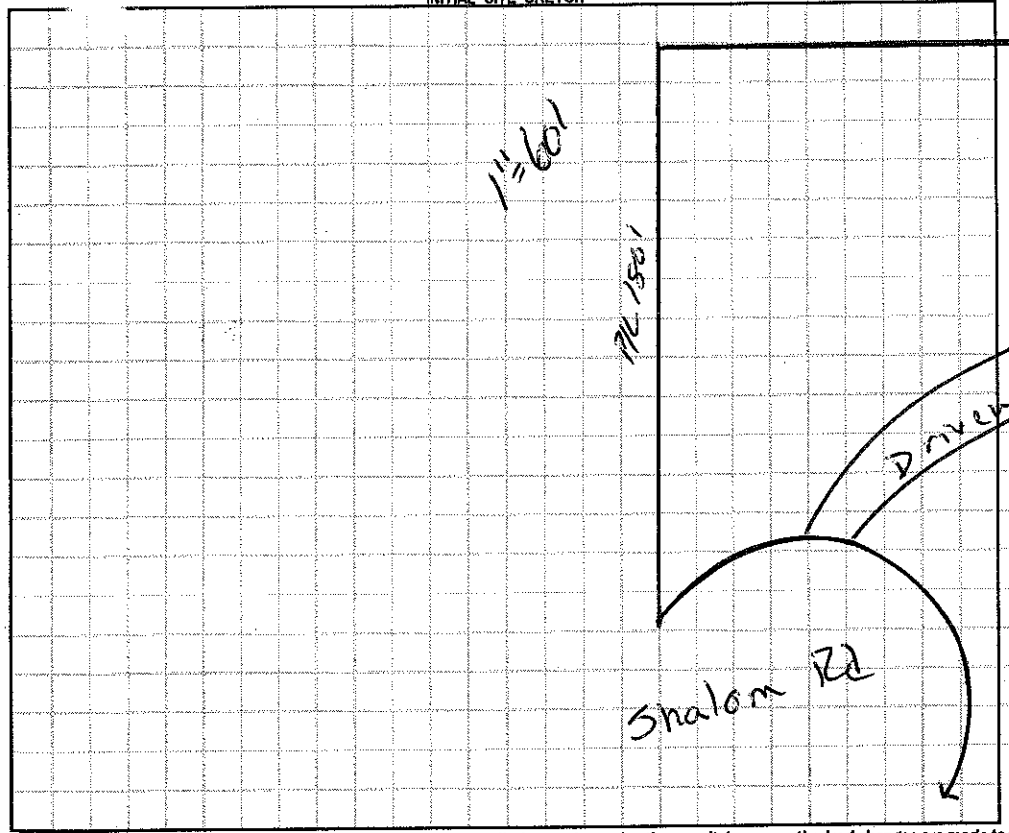

AS BUILT SKETCH

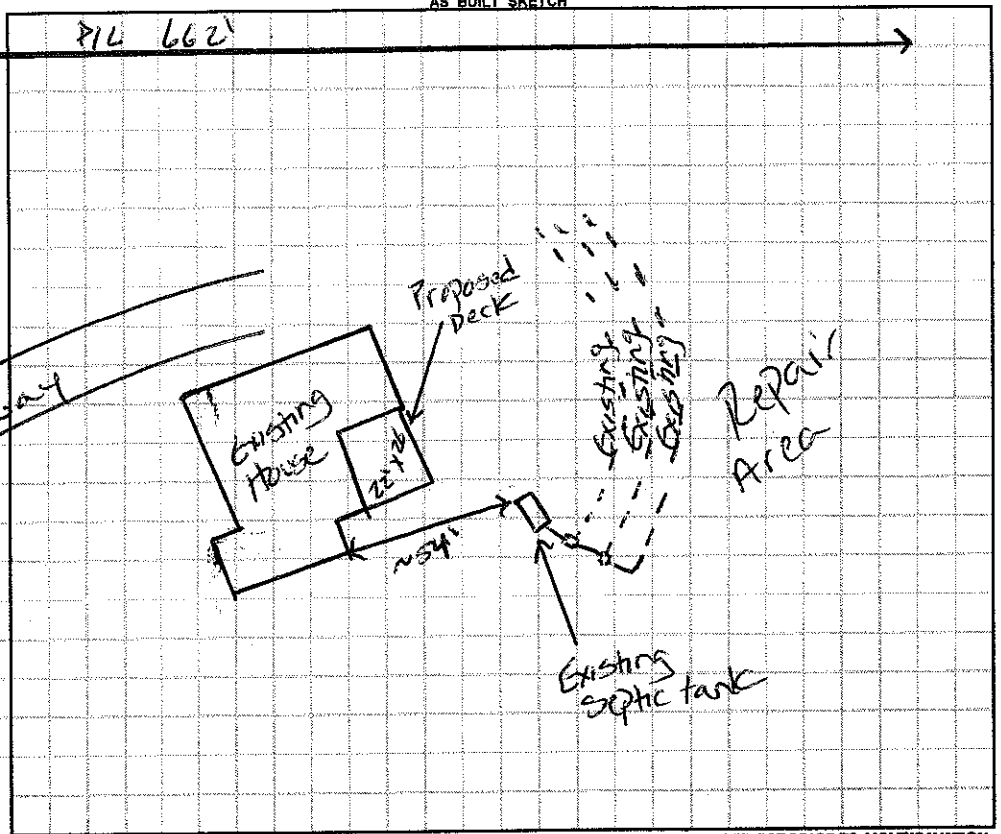

Permit can be suspended or revoked if any false information is supplied toward securing the permit / any unauthorized changes are made to the site / any unauthorized changes are made in the installation of the system. **CONTACT A LOCATOR SERVICE PRIOR TO ANY EXCAVATION**

☐ **IMPROVEMENT PERMIT** *with plat valid without expiration* ☒ **IMPROVEMENT PERMIT** *with site plan valid for 60 mos.* ☐ **AUTHORIZATION TO CONSTRUCT** *valid for period equal to IMPROVEMENT PERMIT--not to exceed 60 mo.*

Owner / Applicant Signature: [signature] Date: 5/18/2016 Installed by:

IMPROVEMENT PERMIT by: Date: OPERATION PERMIT by: Date:

AUTHORIZATION TO CONSTRUCT by: Date: Existing System Inspected by: Justin Henderson Date: 5-17-16

Health Dept. Copy - WHITE Applicant (Final Approval) - YELLOW Applicant (Conditional Approval) - PINK