IREDELL COUNTY HEALTH DEPARTMENT

STATESVILLE 704-878-5305 MOORESVILLE 704-664-5281

IMPROVEMENT PERMIT / AUTHORIZATION TO CONSTRUCT / OPERATION PERMIT / EXISTING SYSTEM INSPECTION

PERMIT # 161432 PIN # 4722-86-8581 DATE 23 June 10

OWNER or APPLICANT Victor Crouch PHONE: ~~Business~~ Cell (704) 450-6087 Home:

OWNER or APPLICANT ADDRESS 138 Raven Creek Dr - Statesville

LOCATION / DIRECTIONS old Mtn Rd. Turn onto Wallace Springs Rd. TL Chris Ln. on Rt. at end.

SUBDIVISION Williams Farm BLOCK / SECTION LOT # 47 LOT AREA 0.86ac. DESIGN FLOW 360gpd L.T.A.R. 0.3/A/D

Septic Tank 1000 Gallons: STB 760 Date 7-2-10

Pump Tank Gallons: P T Date

Pump Make Model Serial #

Nitrification Field No Fields 1 No Lines 4 Linear Feet 300

Trench Width 36" Max. Trench Bottom Depth 36" Gravel Depth NA

☑ New System ☐ Repair ☐ Expansion System Type I II III IV V VI

System Description: 25% Reduction System

Repair System Description: 25% Reduction System -

Maintenance Agreement Required ☐ YES ☑ NO

☑ GRAVITY ☐ PRESSURE

☑ Residence No. Bedrooms 3

☐ Business No. Persons

☐ Other No. Employees

☐ Slab ☐ Crawl Space


☐ Basement w/plumbing ☑ Basement w/o plumbing

Water Supply: ☑ Private ☐ Public ☐ Community


Comments / Conditions: Keep 100' from well / Keep 15' from pool

Comments / Conditions

INITIAL SITE SKETCH

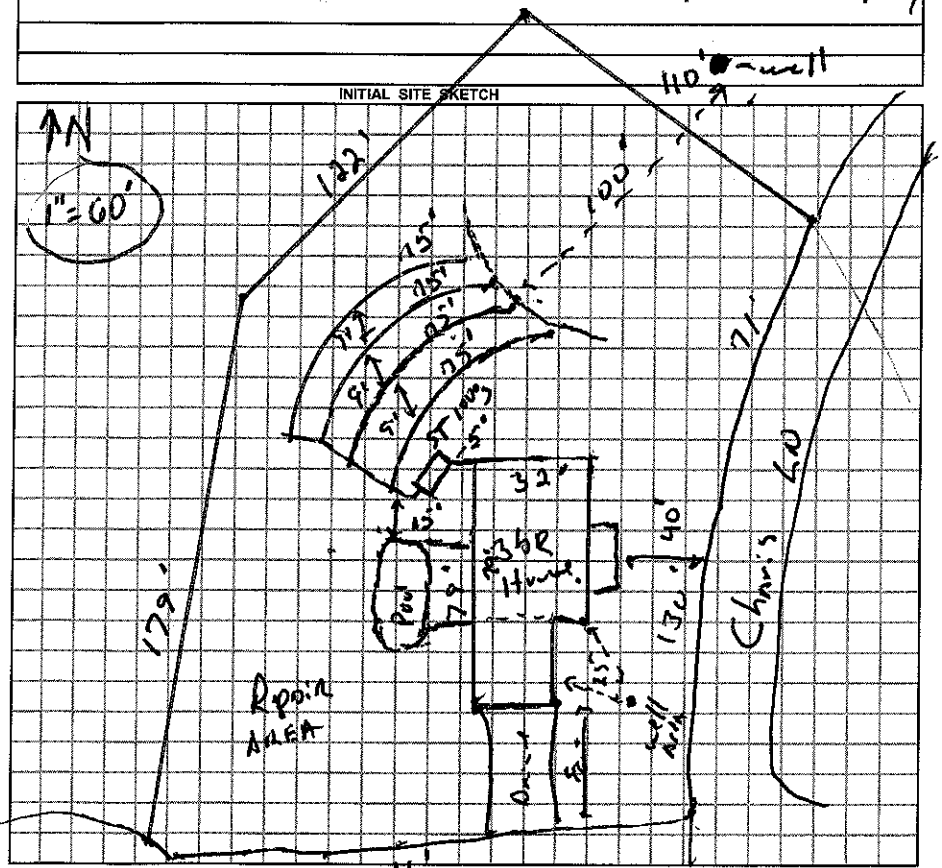

AS BUILT SKETCH

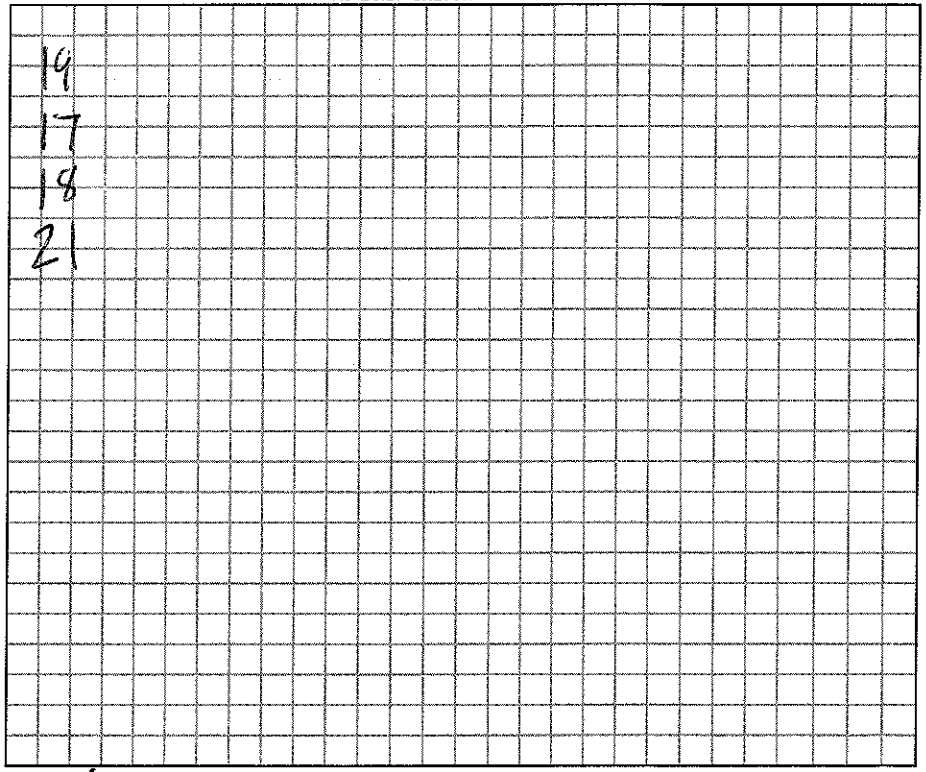

Permit can be suspended or revoked if any false information is supplied toward securing the permit / any unauthorized changes are made to the site / any unauthorized changes are made in the installation of the system.

☐ *IMPROVEMENT PERMIT w / plat valid without expiration.* ☑ *IMPROVEMENT PERMIT w / site plan valid for 60 mos.* ☑ *AUTHORIZATION TO CONSTRUCT valid for period equal to IMPROVEMENT PERMIT-not to exceed 60 mo.*

Owner / Applicant Signature: Victor Scott Crouch Date 6-30-10

Improvement Permit by: [signature], R.S. Date 23 June 10

Authorization to Construct by: [signature], R.S. Date 23 June 10

YOU SHOULD CONTACT A LOCATOR SERVICE PRIOR TO ANY EXCAVATION.

Installed by: A-1 Backhoe

Operation Permit by: [signature] Date: 11-19-10

Existing System Inspected by: Date:

WHITE COPY Environmental Health YELLOW COPY (Final) Owner / Applicant PINK COPY (Initial) Owner / Applicant