IREDELL COUNTY HEALTH DEPARTMENT

STATESVILLE 704-878-5305 MOORESVILLE 704-664-5281

IMPROVEMENT PERMIT / AUTHORIZATION TO CONSTRUCT / OPERATION PERMIT / EXISTING SYSTEM INSPECTION

PERMIT # 161 432 PIN # 4722-86-8581 DATE 23 June 10

OWNER or APPLICANT Victor Crouch PHONE: ~~Business~~ Cell (704) 450-6087 Home:

OWNER or APPLICANT ADDRESS 138 Ravens crest Dr - Statesville

LOCATION / DIRECTIONS Old Mtn Rd. Turn onto Wallace Springs Rd. TL Chanis Ln. on Rt. at end

SUBDIVISION BLOCK / SECTION LOT # LOT AREA 0.86ac± DESIGN FLOW 360gpd L.T.A.R. 0.3x1774

Septic Tank 1000 Gallons: STB 760 Date 7-2-10

Pump Tank Gallons: P T Date

Pump Make Model Serial #

Nitrification Field No Fields 1 No Lines 4 Linear Feet 300

Trench Width 36" Max. Trench Bottom Depth 36" Gravel Depth NA ☑ GRAVITY ☐ PRESSURE

☑ New System ☐ Repair ☐ Expansion System Type I II III IV V VI

System Description: 25% Reduction System

Repair System Description: 25% Reduction System -


Maintenance Agreement Required ☐ YES ☑ NO

☑ Residence No. Bedrooms 3 ☐ Business No. Persons ☐ Other No. Employees ☐ Slab ☐ Crawl Space ☐ Basement w/plumbing ☑ Basement w/o plumbing

Water Supply ☑ Private ☐ Public ☐ Community


Comments / Conditions Keep 100' from well / Keep 15' from pool

INITIAL SITE SKETCH

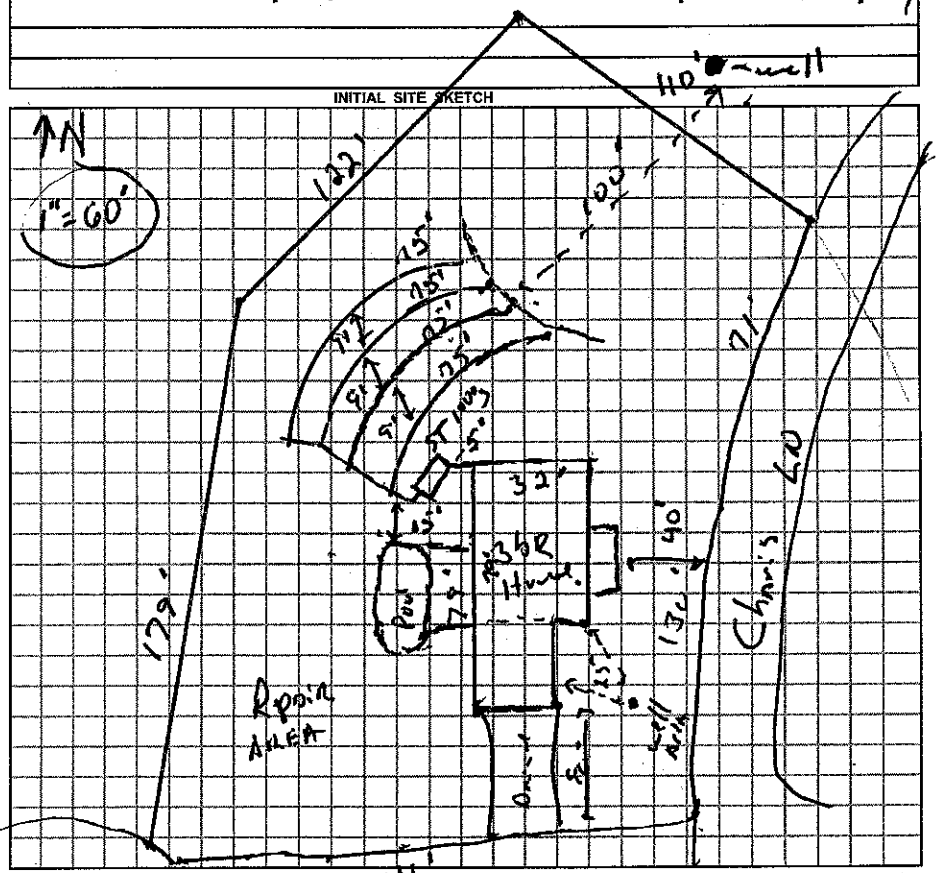

Comments / Conditions

AS BUILT SKETCH

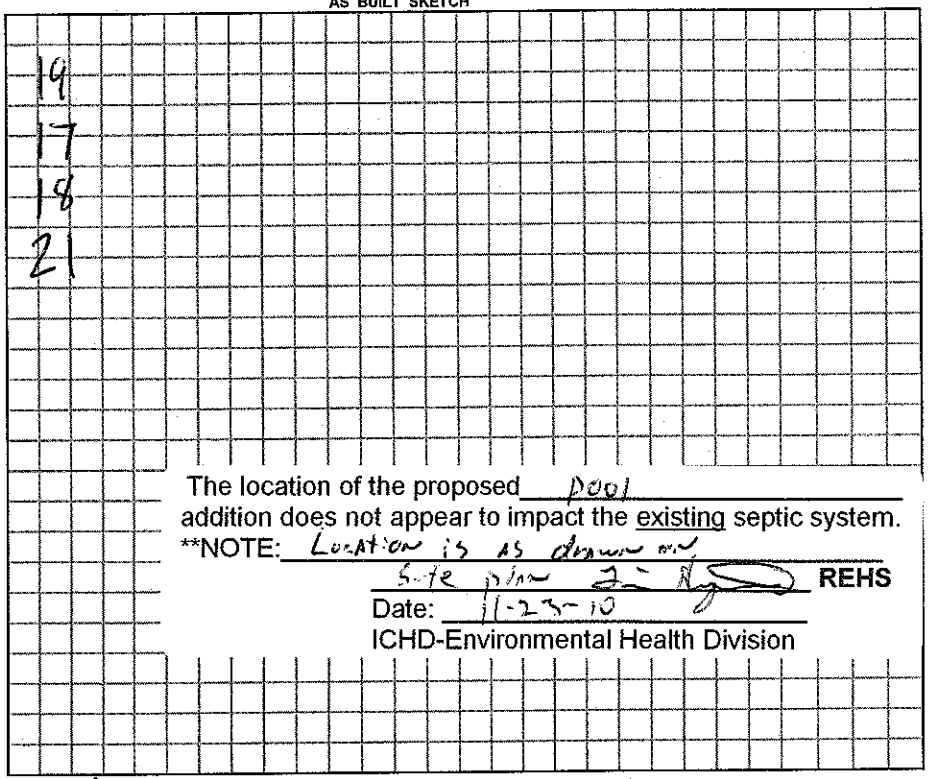

The location of the proposed Pool addition does not appear to impact the existing septic system.

**NOTE: Location is as shown on site plan

REHS

Date: 11-23-10

ICHD-Environmental Health Division

Permit can be suspended or revoked if any false information is supplied toward securing the permit / any unauthorized changes are made to the site / any unauthorized changes are made in the installation of the system.

☐ *IMPROVEMENT PERMIT w / plat valid without expiration.* ☑ *IMPROVEMENT PERMIT w / site plan valid for 60 mos.* ☑ *AUTHORIZATION TO CONSTRUCT valid for period equal to IMPROVEMENT PERMIT-not to exceed 60 mo.*

Owner / Applicant Signature: Victor Crouch Date 6-30-10

Improvement Permit by: R.S. Date 23 June 10

Authorzation to Construct by: R.S. Date 23 June 10

Installed by: A-1 Backhoe

Operation Permit by: Date: 11-19-10

Existing System Inspected by: Date:

YOU SHOULD CONTACT A LOCATOR SERVICE PRIOR TO ANY EXCAVATION.

WHITE COPY Environmental Health YELLOW COPY (Final) Owner / Applicant PINK COPY (Initial) Owner / Applicant