CI

# IREDELL COUNTY HEALTH DEPARTMENT

STATESVILLE 704-878-5305 MOORESVILLE 704-664-5281

## IMPROVEMENT PERMIT / AUTHORIZATION TO CONSTRUCT / OPERATION PERMIT / EXISTING SYSTEM INSPECTION

PERMIT# 14273 PIN# 4722869270

OWNER OR APPLICANT Keith Miller DATE 4-10-07

ADDRESS 117 Airport RD Statesville NC 28677 PHONE: Business 704-402-3764 Home

LOCATION 21 SOUTH @ OAK @ WALLACE SPRGS @ STADIUM AT PWD St + Access

SUBDIVISION Williams Farm BLOCK / SECTION 3 LOT 21 LOT AREA 1.082 SITE CLASS. PS DESIGN FLOW 360 L.T.A.R. 1.5

Septic Tank: 1000 Gallons; STB 760 Date 9-12-07

Pump Tank: Gallons; PT Date

Pump Make: Model Serial No.

Nitrification Field: No Fields 1 Square Feet EQ=1200 Linear Feet 300'

No Lines 4475 Trench Width 36" Max Trench Bottom Depth 36" Gravel Depth N/A

☒ New System ☐ Repair ☐ Expansion System Type: I II III IV V VI

System Description: CONV EZT 25% Red Dev

Repair System Description: SAME

Maintenance Agreement Required: ☐ Yes ☒ No

☒ Gravity ☐ Pressure ☐ Slab ☒ Crawl Space ☐ Basement w/plumbing ☐ Basement wo/plumbing

☒ House/Mod. Home No. Bedrooms 3

☐ Mobile Home No. Persons 6

☐ Business No. Employees

☐ Other

Water Supply: ☒ Individual ☐ Public ☐ Community

Comments:/Conditions: (1) DUE TO SAPROLITE WELLS MUST BE 100' AWAY FROM INITIAL SYSTEM & REPAIR AREA (2) HOUSE & SEPTIC Completely FLAGGED OUT

Comments:/Conditions: POLYLOK FILTER & MARVOR INSTALLED AS DRAWN ☒ BUILDER OK'D SYSTEM CHANGES & ACKNOWLEDGED SYSTEM 10' + OFF P/L. ☒ Keith Miller

INITIAL SITE SKETCH

SEE ATTACHED SYSTEM DESIGN BY CORNER LOOK, R.I.S.

AS BUILT SKETCH

WELL DRILLED AT TIME OF CHECK. WELLS 100' + FROM SEPTIC.

Permit can be suspended or revoked if any false information is supplied toward securing the permit/any unauthorized changes are made to the site/any unauthorized changes are made in the installation of the system. Improvement Permit with plat valid without expiration ☐ Improvement Permit with site plan valid for sixty months ☒ Authorization to Construct is valid for a period equal to that of Improvement Permit – not to exceed sixty months.

Signed: ☒ Keith Miller date 4-10-07

Improvement Permit by: date 4-10-07

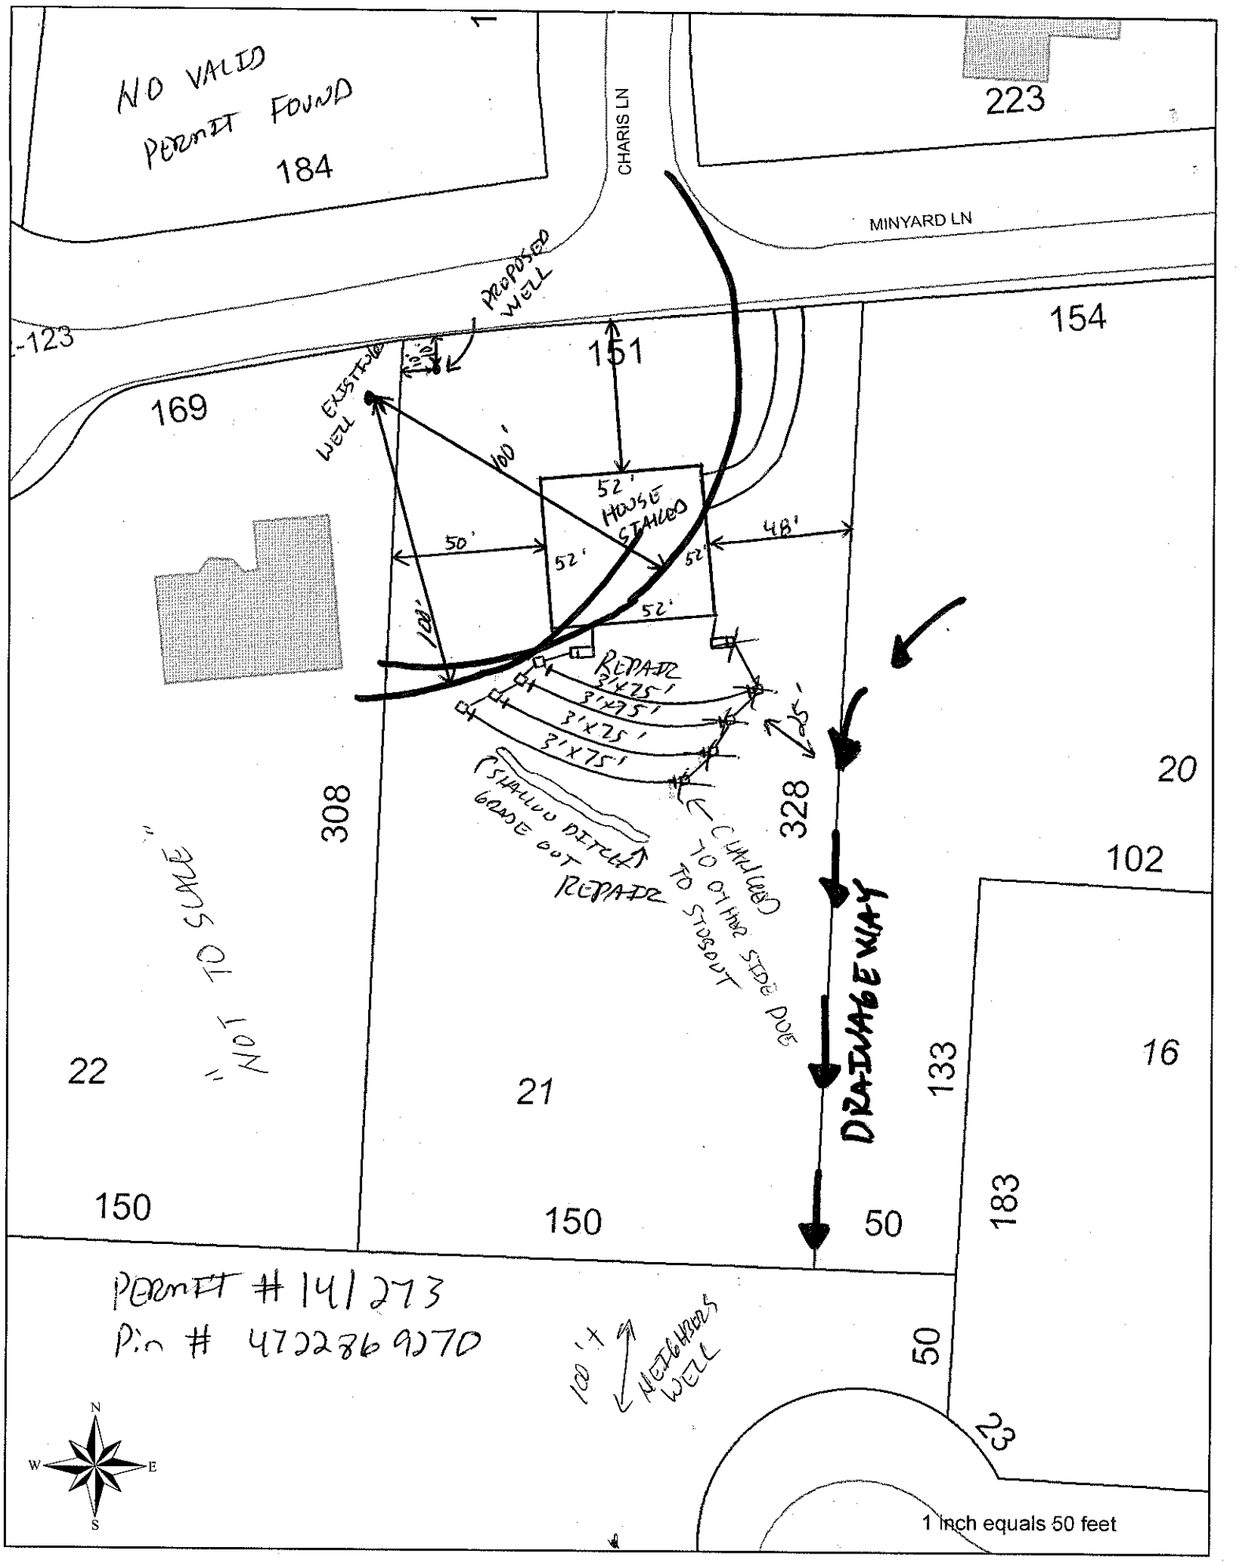
Authorization to Construct by: date 4-10-07

Installed by: RANDY Miller & Son STS 1128 I

Operation Permit by: date 1-31-08

Existing System Inspection by: date

HEALTH DEPT. COPY: WHITE OWNER COPY (FINAL): YELLOW OWNER COPY (INITIAL): PINK


NO VALID
PERMIT FOUND
184
CHARIS LN
223
MINYARD LN
PROPOSED WELL
EXISTING WELL
169
151
154
52'
HOUSE STAKED
50'
48'
100'
120'
REPAIR
3'X75'
3'X75'
3'X75'
3'X75'
SHALLOW DITCH
GRADE OUT
REPAIR
CHANGED TO OTHER SIDE POE
TO STAKOUT
308
328
20
102
NOT TO SCALE
22
21
133
16
150
150
50
183
PERMIT #141273
PIN # 472286 9270
100'+
NEIGHBORS WELL
50
23
N
W
E
S
1 inch equals 50 feet