IREDELL COUNTY HEALTH DEPARTMENT

STATESVILLE 704-878-5305 CI MOORESVILLE 704-664-5281

IMPROVEMENT PERMIT / AUTHORIZATION TO CONSTRUCT / OPERATION PERMIT / EXISTING SYSTEM INSPECTION

PERMIT# 117629 PIN# ~~4722-86-9931~~ 4722-86-9990 DATE 1-20-04

OWNER OR CONTRACTOR ALL SEASONS CONTRACTORS PHONE: Business 704-902-3199 Home

ADDRESS 2534 Hickory Hwy STATESVILLE, NC 28677

LOCATION 21 SOUTH, (R) OLD MOUNTAIN RD, (R) WALLACE SPRINGS, (L) CHRIS LANE, ON RIGHT IN CURVE LOT # 22

SUBDIVISION Williams Farm BLOCK / SECTION LOT ~~22~~ 46 LOT AREA 1.77 AC SITE CLASS. PS DESIGN FLOW 480 L.T.A.R. .3

Septic Tank: 1000 Gallons; STB 1000 Date 3-10-04
Pump Tank: Gallons; PT Date
Pump Make: Model Serial No.
Nitrification Field: No Fields 1 Square Feet EQ=600' Linear Feet 400'
No Lines 4x100' Trench Width 36" Max Trench Bottom Depth 36" Gravel Depth N/A

☒ New System ☐ Repair System Type: I, II, III, IV, V, VI
System Description: GRAV 25% REDUCTION
Repair System Description: SAME
Maintenance Agreement Required: ☐ Yes ☒ No

☒ House/Mod. Home No. Bedrooms 4
☐ Mobile Home No. Bathrooms 3
☐ Business No. Employees
☐ Other
☐ Slab ☒ Crawl Space ☐ Basement w/plumbing ☐ Basement wo/plumbing


Water Supply: ☒ Individual ☐ Public ☐ Community WELL

Comments:/Conditions: (1) INSTALL LINES ON CONTOURS (2) MAINTAIN SETBACKS & KEEP 100' SEPERATION BETWEEN THE WELL & ANY PART OF THE SEPTIC & NEIGHBORS


Comments:/Conditions: (4) AT TIME OF EVALUATION OWNER SAYS NO OTHER PERMITS HAVE BEEN ISSUED ON THE NEIGHBORING LOTS ON EITHER SIDE OF LOT 22.

SEPTIC, SAPROLITE

INITIAL SITE SKETCH

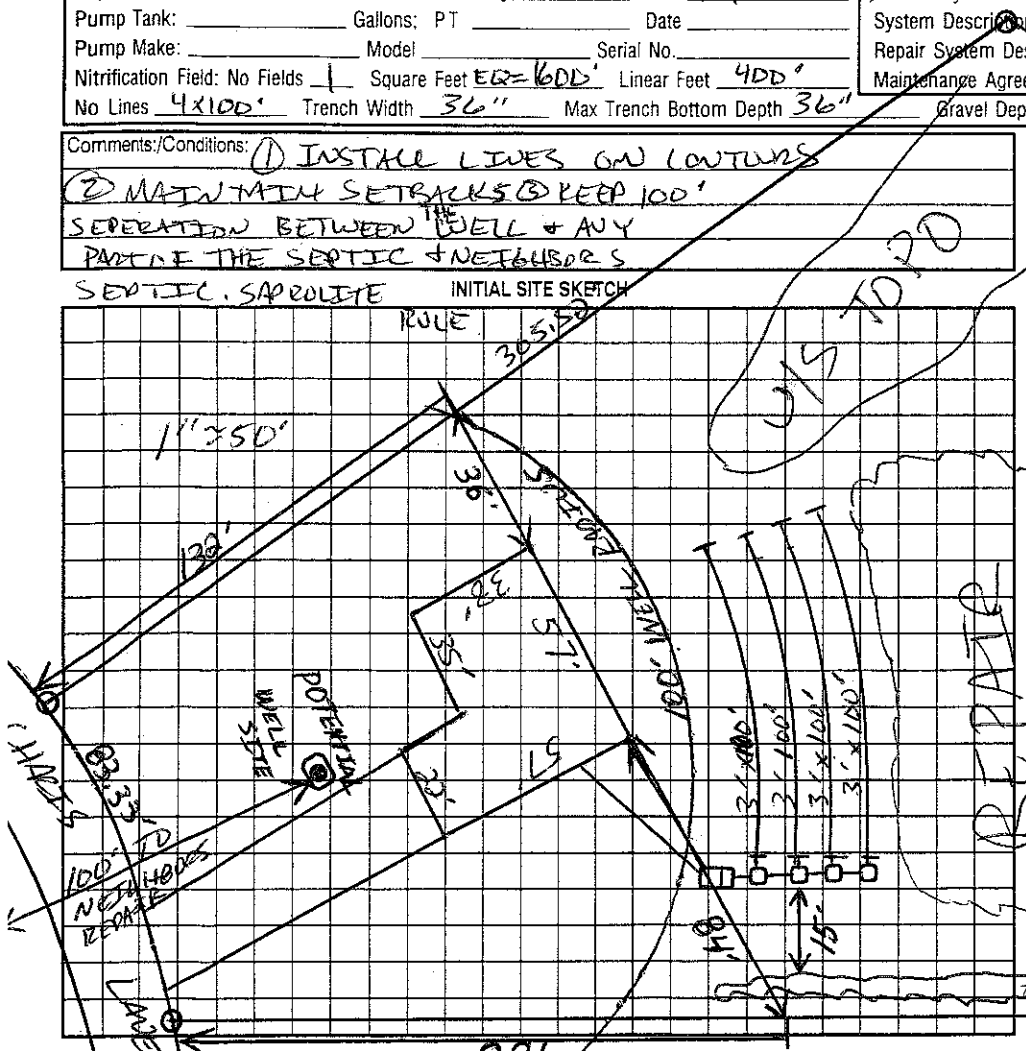

AS BUILT SKETCH

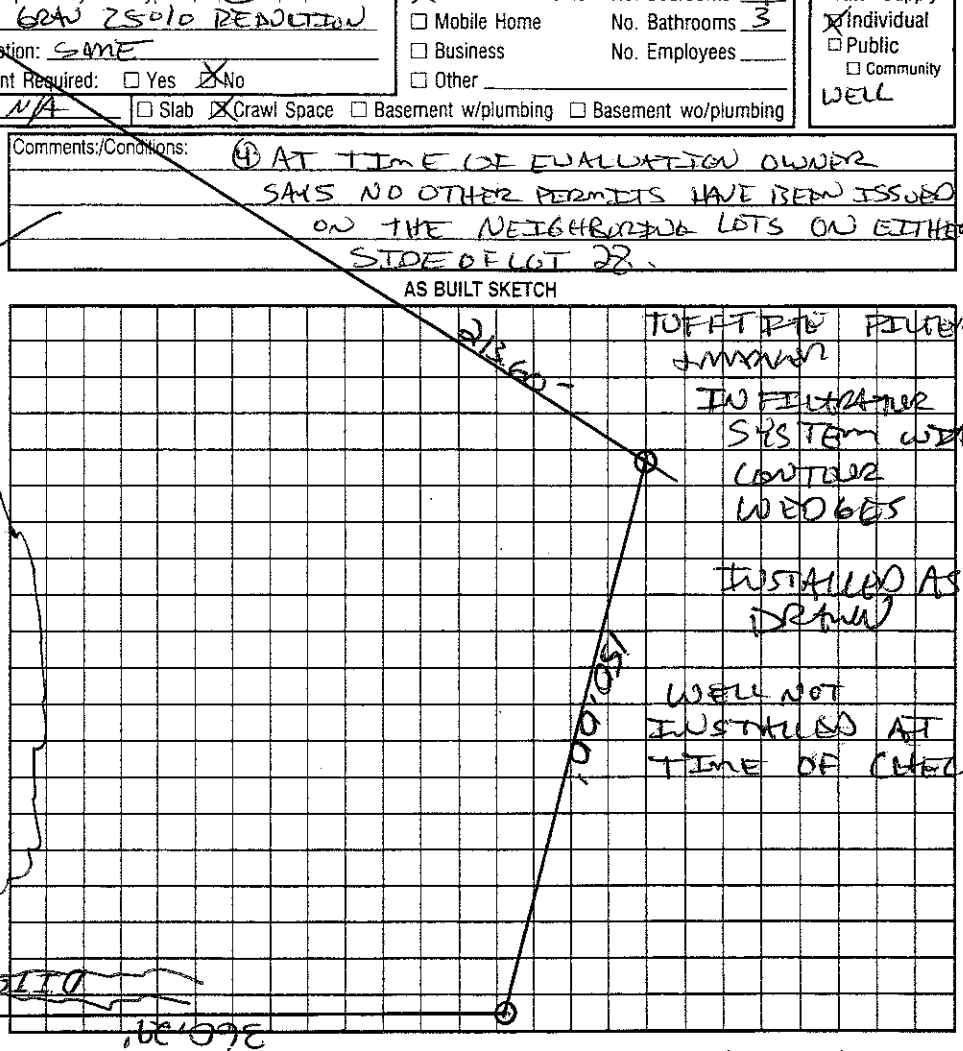

Permit can be suspended or revoked if any false information is supplied toward securing the permit/any unauthorized changes are made to the site/any unauthorized changes are made in the installation of the system. Improvement Permit with plat valid without expiration. Improvement Permit with site plan valid for sixty months. Authorization to Construct is valid for a period equal to that of Improvement Permit – not to exceed sixty months.

Signed: date 1-21-04 Installed by: ADAMS GRADING

Improvement Permit by: date 1-20-04 Operation Permit by: date 5-12-04

Authorization to Construct by: date 1-20-04 Existing System Inspection by: date

HEALTH DEPT. COPY: WHITE OWNER COPY (FINAL): YELLOW OWNER COPY (INITIAL): PINK