IREDELL COUNTY HEALTH DEPARTMENT

STATESVILLE 704-878-5305 MOORESVILLE 704-664-5281

IMPROVEMENT PERMIT / AUTHORIZATION TO CONSTRUCT / OPERATION PERMIT / EXISTING SYSTEM INSPECTION

PERMIT# 73429 PIN# 4722929212 DATE 5-19-98

OWNER OR CONTRACTOR Barbara ORR PHONE: Business 664 4808 Home

ADDRESS 146 W Statesville Ave Mooresville N.C.

LOCATION at Troutman Turn OMR Past S.I. Highschool TU Southwood Turn Pilgrim cr.

SUBDIVISION Southwood BLOCK / SECTION LOT 42 LOT AREA 1.6 acres SITE CLASS 4S DESIGN FLOW 360 L.T.A.R. .33 acres

Septic Tank: 1000 Gallons; STB 1012 Date 3-19-99

Pump Tank: Gallons; PT Date

Pump Make: Model Serial No.

Nitrification Field: No Fields 1 Square Feet 1080 Linear Feet 360

No Lines 4 Trench Width 36" Max Trench Bottom Depth 36"

[X] New System [ ] Repair System Type: [I] II, III, IV, V, VI

System Description: Conv. Gravity

Repair System Description: Pump To Chamber

Maintenance Agreement Required: [ ] Yes [X] No or HOS

Gravel Depth 12"

[X] Slab [ ] Crawl Space [ ] Basement w/plumbing [ ] Basement wo/plumbing

[X] House/Mod. Home No. Bedrooms 3

[ ] Mobile Home No. Bathrooms 2

[ ] Business No. Employees


[ ] Other

Water Supply: [X] Individual [ ] Public [ ] Community


Comments:/Conditions:

Comments:/Conditions:

INITIAL SITE SKETCH

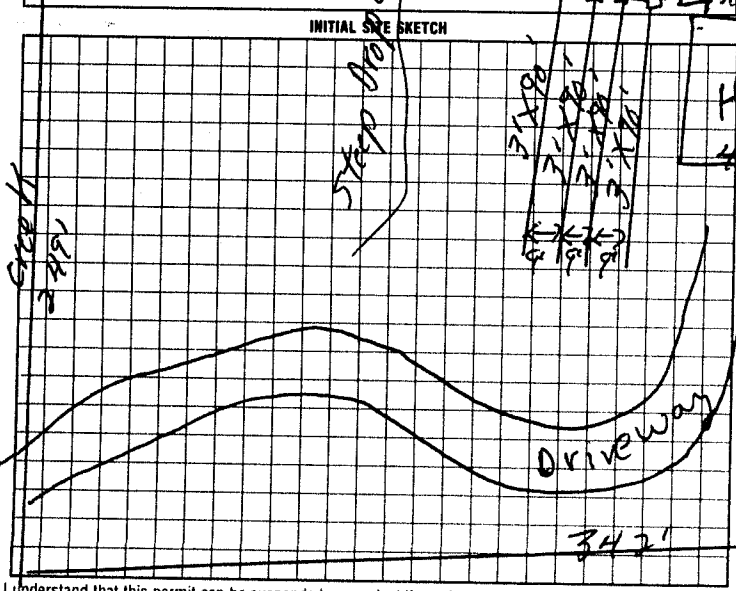

AS BUILT SKETCH

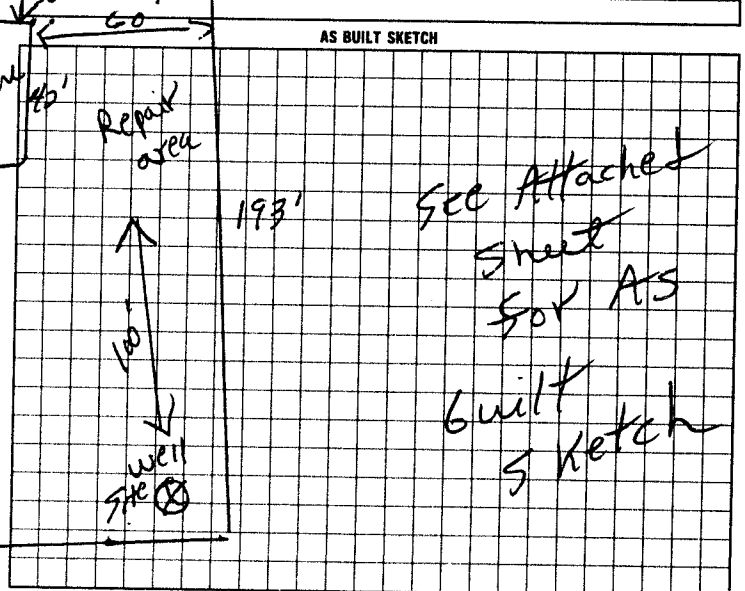

See Attached Sheet for As built Sketch

I understand that this permit can be suspended or revoked if any false information is supplied toward securing the permit/any unauthorized changes are made to the site/any unauthorized changes are made in the installation of the system. Improvement Permit with plat valid without expiration. Improvement Permit with site plan valid for sixty months. Authorization to Construct is valid for a period equal to that of Improvement Permit – not to exceed sixty months.

Signed: X Gordon C [illegible] date 5/19/98 Installed by: C+W Grading

Improvement Permit by: P.C. Moore date 5-19-98 Operation Permit by: P.C. Moore date 5-11-99

Authorization to Construct by: P.C. Moore date 5-19-98 Existing System Inspection by: date

HEALTH DEPT COPY: WHITE INSPECTION COPY (FINAL): GREEN OWNER COPY (FINAL): YELLOW INSPECTION COPY (INITIAL): PINK OWNER COPY (INITIAL): GOLD