IREDELL COUNTY HEALTH DEPARTMENT

STATESVILLE 704-878-5305 MOORESVILLE 704-664-5281

IMPROVEMENT PERMIT / AUTHORIZATION TO CONSTRUCT / OPERATION PERMIT / EXISTING SYSTEM INSPECTION

PERMIT # 15521I PIN # 4722941449 DATE 3-11-09

OWNER or APPLICANT DAVID RANKIN PHONE: Business Home: 704-528-3539

OWNER or APPLICANT ADDRESS 115 Trustmen Farm Rd Statesville NC 28677

LOCATION / DIRECTIONS 21 SOUTH (R) ON R (L) Trustmen Farm (L) ATBDX #115

SUBDIVISION BLOCK / SECTION LOT # 2 LOT AREA 1.031 DESIGN FLOW L.T.A.R. EXISTING

Septic Tank EXISTING Gallons: STB Date

Pump Tank Gallons: P T Date

Pump Make Model Serial #

Nitrification Field No Fields No Lines 3 Linear Feet

Trench Width Max. Trench Bottom Depth Gravel Depth

☐ New System ☐ Repair ☐ Expansion System Type I (II) III IV V VI

System Description: GRAVITY CONV

Repair System Description:

Maintenance Agreement Required ☐ YES ☒ NO

☒ GRAVITY ☐ PRESSURE

☒ Residence No. Bedrooms

☐ Business No. Persons

☐ Other No. Employees

☐ Slab ☐ Crawl Space

☐ Basement w/plumbing ☐ Basement w/o plumbing

Water Supply: ☒ Private ☐ Public ☐ Community

Comments / Conditions (1) This is a properly functioning system in use (2) Have built in 40's no old record found. (3) New Front Porch will not affect existing system in no way.

Comments / Conditions

INITIAL SITE SKETCH

SEE ATTACHED EXISTING CHECK

DONE BY LARRY COOK, R.S.

AS BUILT SKETCH

Permit can be suspended or revoked if any false information is supplied toward securing the permit / any unauthorized changes are made to the site / any unauthorized changes are made in the installation of the system.

☐ *IMPROVEMENT PERMIT w / plat valid without expiration.* ☐ *IMPROVEMENT PERMIT w / site plan valid for 60 mos.* ☐ *AUTHORIZATION TO CONSTRUCT valid for period equal to IMPROVEMENT PERMIT-not to exceed 60 mo.*

Owner / Applicant Signature: Rob A Rank Date 3/12/09

Improvement Permit by: Date

Authorization to Construct by: Date

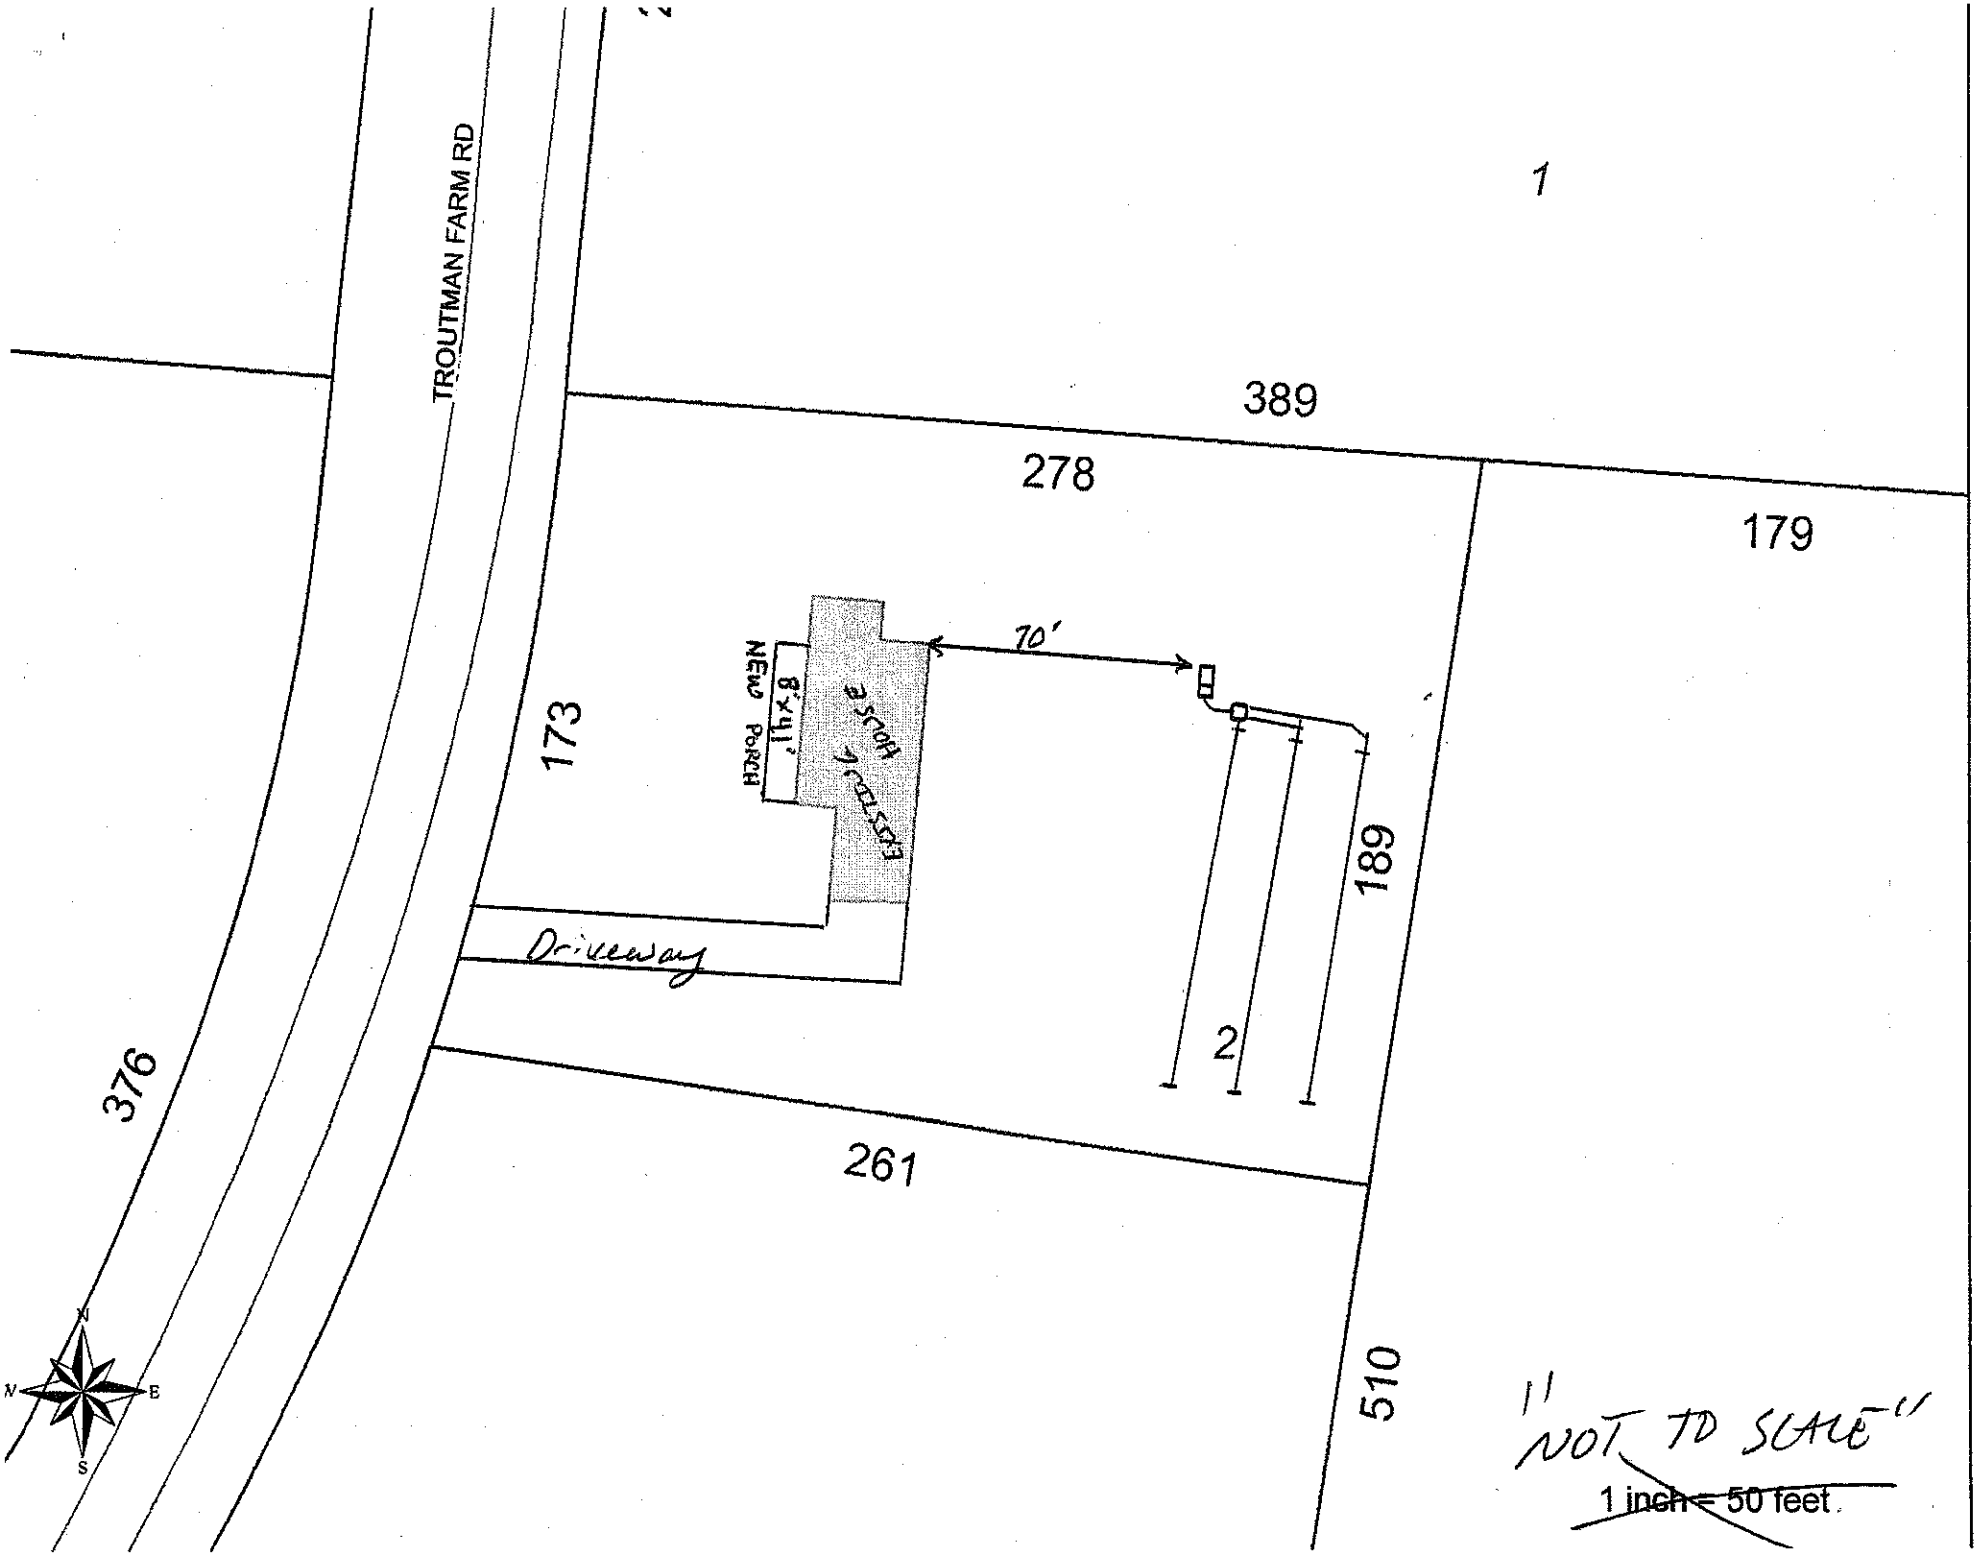
Installed by:

Operation Permit by: Date:

Existing System Inspected by: Date: 3-11-09

YOU SHOULD CONTACT A LOCATOR SERVICE PRIOR TO ANY EXCAVATION.

WHITE COPY Environmental Health YELLOW COPY (Final) Owner / Applicant PINK COPY (Initial) Owner / Applicant


TROUTMAN FARM RD
1
389
278
179
173
189
261
510
376
70'
NEW PORCH 8'x11'
EXISTING 1 STORY HOUSE
Driveway
2
N
S
E
W
"NOT TO SCALE"
1 inch = 50 feet