IREDELL COUNTY HEALTH DEPARTMENT

STATESVILLE 704-878-5305 MOORESVILLE 704-664-5281

IMPROVEMENT PERMIT / AUTHORIZATION TO CONSTRUCT / OPERATION PERMIT / EXISTING SYSTEM INSPECTION

PERMIT # 15521I PIN # 4722947449 DATE 3-11-09

OWNER or APPLICANT DAVID RANKIN PHONE: Business Home: 704-528-3539

OWNER or APPLICANT ADDRESS 115 Troutmen Farm Rd Statesville NC 28677

LOCATION / DIRECTIONS 21 SOUTH (R) ON (L) Troutmen Farm (L) AT BOX #115

SUBDIVISION BLOCK / SECTION LOT # 2 LOT AREA 1.031 DESIGN FLOW L.T.A.R. EXISTING

Septic Tank EXISTING Gallons: STB Date

Pump Tank Gallons: P.T Date

Pump Make Model Serial #

Nitrification Field No Fields No Lines 3 Linear Feet

Trench Width Max. Trench Bottom Depth Gravel Depth

☐ New System ☐ Repair ☐ Expansion System Type I (II) III IV V VI

System Description: GRAVITY CONV

Repair System Description:

Maintenance Agreement Required ☐ YES ☒ NO

☒ GRAVITY ☐ PRESSURE

☒ Residence No. Bedrooms

☐ Business No. Persons

☐ Other No. Employees

☐ Slab ☐ Crawl Space

☐ Basement w/plumbing ☐ Basement w/o plumbing

Water Supply: ☒ Private ☐ Public ☐ Community

Comments / Conditions (1) This is a properly functioning system in use (2) House built in 40's no old record found. (3) New Front Porch will not affect existing system in any way.

Comments / Conditions

INITIAL SITE SKETCH

SEE ATTACHED EXISTING CHECK

DONE BY LARRY CODY, R.S.

AS BUILT SKETCH

The location of the proposed 10' x 15' deck addition does not appear to impact the existing septic system.

**NOTE: Septic System is on the far west p/l away from deck 70'+ away

REHS

Date: 9-23-10

ICHD-Environmental Health Division

Permit can be suspended or revoked if any false information is supplied toward securing the permit / any unauthorized changes are made to the site / any unauthorized changes are made in the installation of the system.

☐ *IMPROVEMENT PERMIT w / plat valid without expiration.* ☐ *IMPROVEMENT PERMIT w / site plan valid for 60 mos.* ☐ *AUTHORIZATION TO CONSTRUCT valid for period equal to IMPROVEMENT PERMIT-not to exceed 60 mo.*

Owner / Applicant Signature: Robert Rankin Date 3/12/09

Improvement Permit by: Date

Authorzation to Construct by: Date

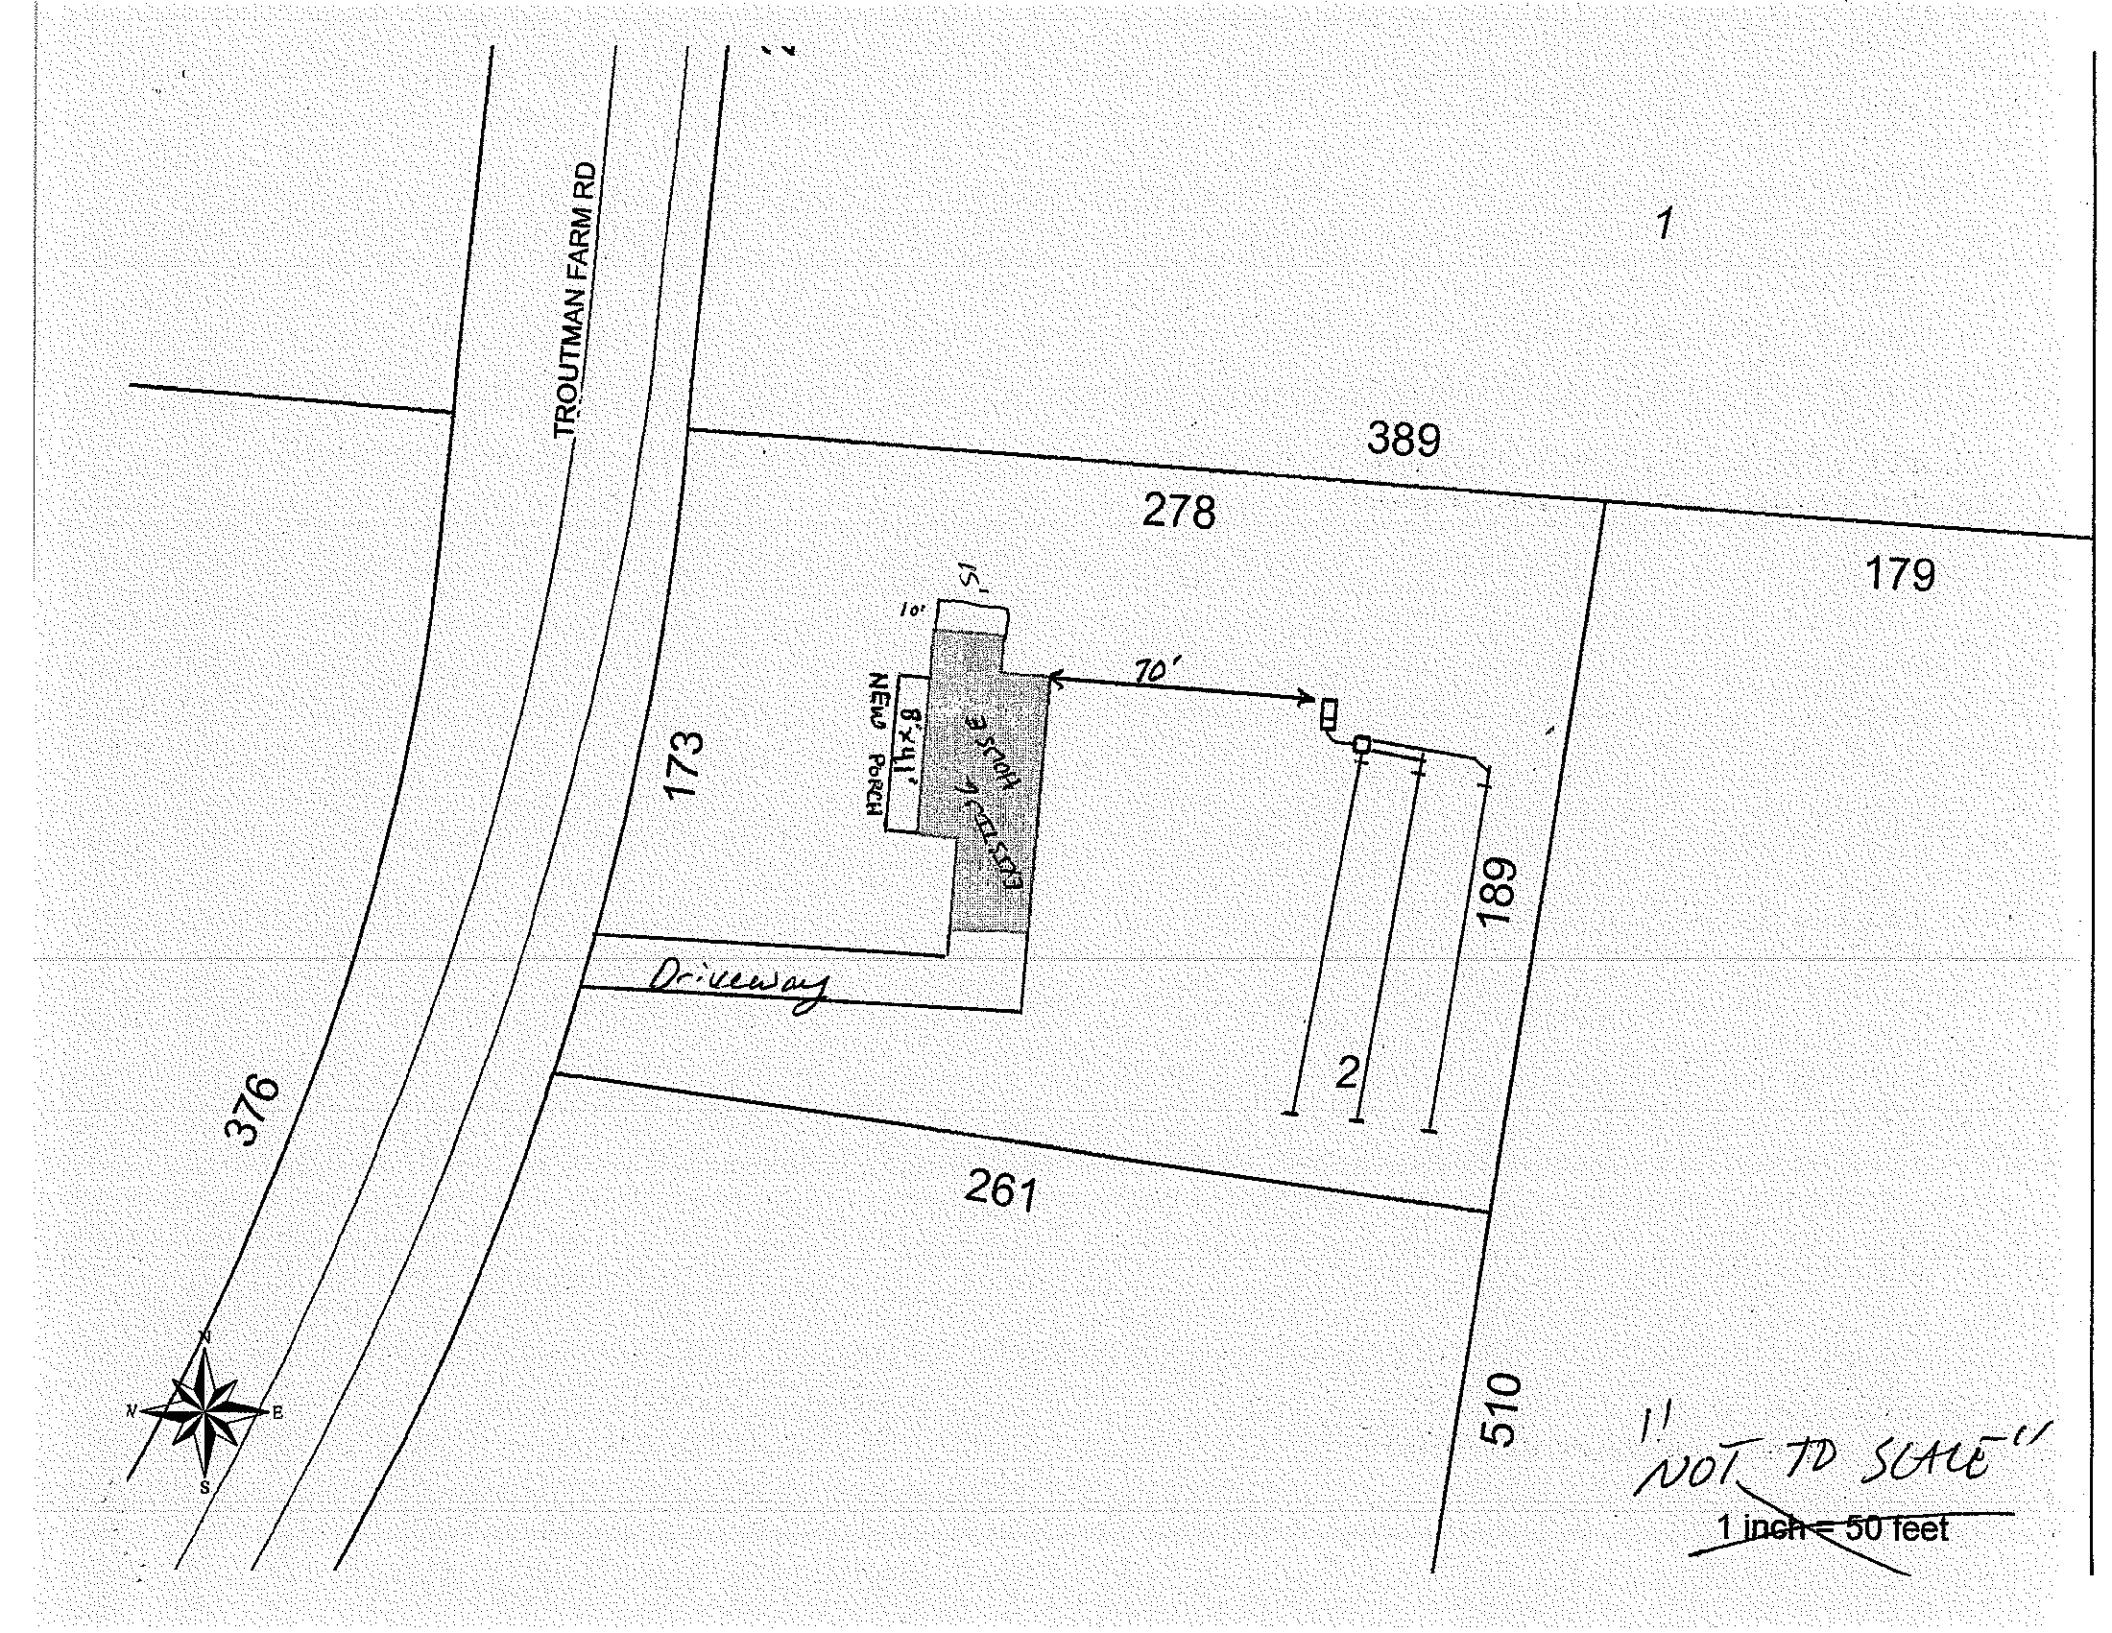
Installed by:

Operation Permit by: Date:

Existing System Inspected by: Date: 3-11-09

YOU SHOULD CONTACT A LOCATOR SERVICE PRIOR TO ANY EXCAVATION.

WHITE COPY Environmental Health YELLOW COPY (Final) Owner / Applicant PINK COPY (Initial) Owner / Applicant


TROUTMAN FARM RD
1
389
278
179
173
376
261
510
189
70'
10'
15'
NEW PORCH
8'x11'
EXISTING HOUSE #1
Driveway
2
N
E
S
W
"NOT TO SCALE"
1 inch = 50 feet