IREDELL COUNTY HEALTH DEPARTMENT

STATESVILLE 704-878-5305 MOORESVILLE 704-664-5281

IMPROVEMENT PERMIT / AUTHORIZATION TO CONSTRUCT / OPERATION PERMIT / EXISTING SYSTEM INSPECTION

PERMIT# 80224 PIN# 4722962323 DATE 4-13-99

OWNER OR CONTRACTOR Todd MASON PHONE: Business 704 872-7304 Home

ADDRESS 345 River Hill Rd STATESville NC

LOCATION 011 Mt Road (R) Wallace Springs (L) .8 mile on Left End of Cul de Sac

SUBDIVISION Williams FARM BLOCK / SECTION LOT 14 LOT AREA .90 Ac SITE CLASS PS DESIGN FLOW 360 L.T.A.R. .3 .25 Repair

Septic Tank: 1000 Gallons; STB 312 Date 4.28.99

Pump Tank: Gallons; PT Date

Pump Make: Model Serial No.

Nitrification Field: No Fields 1 Square Feet 1200 Linear Feet 25% Red 300ft

No Lines 10 x 30ft Trench Width 36" Max Trench Bottom Depth 36"

[X] New System [ ] Repair System Type: I, II, III, IV, V, VI

System Description 25% Reduction GRAVITY

Repair System Description: Pump 50% Reduction .25 LTAR

Maintenance Agreement Required: [ ] Yes [X] No

~~Gravel~~ Depth 6" Sand [ ] Slab [X] Crawl Space [ ] Basement w/plumbing [X] Basement wo/plumbing

[X] House/Mod. Home No. Bedrooms 3

[ ] Mobile Home No. Bathrooms 2

[ ] Business No. Employees

[ ] Other

Water Supply: [X] Individual [ ] Public [ ] Community

WELL


Comments/Conditions: 220ft PL

INSTALL Lines on Contour Keep Septic Tank 15 ft


Remove TERRACE from BASEMENT CUT

Comments/Conditions: 50 CHAMBERS OR 30 HBS SECTIONS


POTENTIAL INITIAL SITE SKETCH

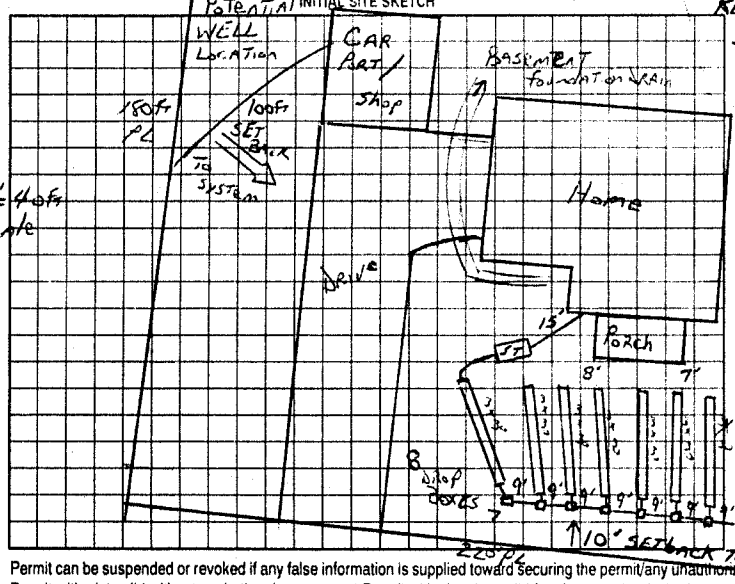

REPAIR AREA 50% Reduction @ .26 LTAR

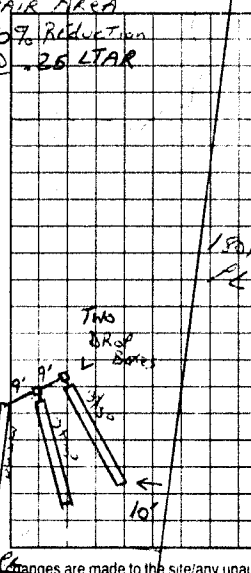

AS BUILT SKETCH

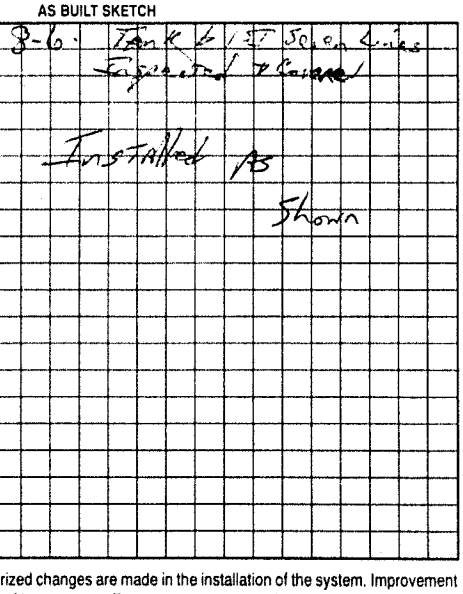

Permit can be suspended or revoked if any false information is supplied toward securing the permit/any unauthorized changes are made to the site/any unauthorized changes are made in the installation of the system. Improvement Permit with plat valid without expiration. Improvement Permit with site plan valid for sixty months. Authorization to Construct is valid for a period equal to that of Improvement Permit – not to exceed sixty months.

Signed: Todd W. Mason date 4-14-99

Improvement Permit by: J. Potter date 4 13 99

Authorization to Construct by: J. Potter date 4/13/99

Installed by: James Hedden

Operation Permit by: J. Potter date 8-9-99

Existing System Inspection by: date

HEALTH DEPT. COPY WHITE OWNER COPY (FINAL) YELLOW OWNER COPY (INITIAL) PINK