CI

IREDELL COUNTY HEALTH DEPARTMENT

STATESVILLE 704-878-5305 MOORESVILLE 704-664-5281

IMPROVEMENT PERMIT / AUTHORIZATION TO CONSTRUCT / OPERATION PERMIT / EXISTING SYSTEM INSPECTION

PERMIT# 101015 PIN# 4722.95 8840 DATE 7/6/01

OWNER OR CONTRACTOR Randall Myers PHONE-Business Home 704 878-0616

ADDRESS 2534 Hickory Hwy Statesville NC 28677

LOCATION Old Mtn Rd, to Wallace Springs, TL Charis, TL Shalom PL. on Lt in Cul-de-sac

SUBDIVISION Williams FM BLOCK / SECTION LOT 18 LOT AREA 0.80 Ac. SITE CLASS. PS DESIGN FLOW 360 L.T.A.R. 0.3

Septic Tank: 1000 Gallons: STB 1000 Date 7-18-01

Pump Tank: Gallons: PT Date

Pump Make: Model Serial No.

Nitrification Field: No Fields 1 Square Feet 1200 Linear Feet 400

No Lines 3@133' Trench Width 36" Max Trench Bottom Depth 36" Gravel Depth 12"

X New System ☐ Repair System Type: I, II, III, IV, V, VI

System Description: Gravity Conventional

Repair System Description: Same

Maintenance Agreement Required: ☐ Yes X No

X House/Mod. Home ☐ Mobile Home ☐ Business ☐ Other

No. Bedrooms 3 No. Bathrooms 2 No. Employees


☐ Slab X Crawl Space ☐ Basement w/plumbing ☐ Basement wo/plumbing

Water Supply: X Individual ☐ Public ☐ Community

Comments/Conditions: Install Lines on Contour - center feed Lines - Keep well 50' from septic System

Comments/Conditions: Checked 1 ft Low-grade Okay 10-9-01 mf
- poly/ok filter Installed
- Septic Tank marker Installed.
EVERYTHING CHECKED OK (LL) 10-9-01

INITIAL SITE SKETCH

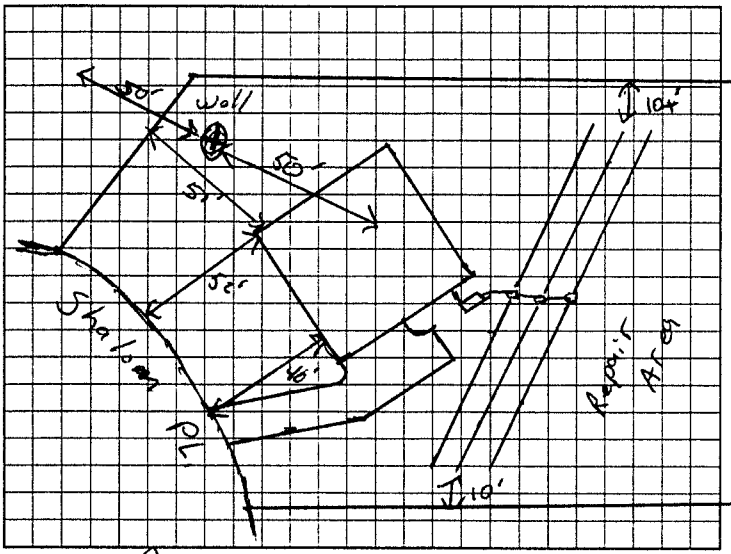

AS BUILT SKETCH

INSTALLED AS SHOWN

Permit can be suspended or revoked if any false information is supplied toward securing the permit/any unauthorized changes are made to the site/any unauthorized changes are made in the installation of the system. Improvement Permit with plat valid without expiration. Improvement Permit with site plan valid for sixty months. Authorization to Construct is valid for a period equal to that of Improvement Permit – not to exceed sixty months.

Signed: date 7/16/01 Installed by: ADAMS GRADING

Improvement Permit by: RSI date 7/6/01 Operation Permit by: LS date 10-9-01

Authorization to Construct by: RSI date 7/6/01 Existing System Inspection by: date

HEALTH DEPT. COPY: WHITE OWNER COPY (FINAL): YELLOW OWNER COPY (INITIAL): PINK