878 5310 10:00

IREDELL COUNTY HEALTH DEPARTMENT

STATESVILLE 704-878-5305 MOORESVILLE 704-664-5281

IMPROVEMENT PERMIT / AUTHORIZATION TO CONSTRUCT / OPERATION PERMIT / EXISTING SYSTEM INSPECTION

PERMIT# _____ PIN# _____ DATE 1-27-00

OWNER OR CONTRACTOR Kaye Payne PHONE: Business 873-7411 Home 528 5958

ADDRESS 858 Wallace Sp Rd Trout man

LOCATION 21 S TR old mtn Rd TR wallace sp Rd 1/8 mi left

SUBDIVISION _____ BLOCK / SECTION _____ LOT _____ LOT AREA 1/2 acre+ SITE CLASS _____ DESIGN FLOW 360 L.T.A.R. .35

Septic Tank: Ex. Gallons; STB _____ Date _____

Pump Tank: _____ Gallons; PT _____ Date _____

Pump Make: _____ Model _____ Serial No. _____

Nitrification Field: No Fields 1 Square Feet 636 Linear Feet 212.5

No Lines 4 Trench Width 36" Max Trench Bottom Depth 36" Gravel Depth N/A

☒ New System ☒ Repair System Type: I, II, III, IV, V, VI

System Description: _____

Repair System Description: Gravity 25% Red.

Maintenance Agreement Required: ☐ Yes ☒ No

☒ House/Mod. Home No. Bedrooms 3

☐ Mobile Home No. Bathrooms 1

☐ Business No. Employees _____

☐ Other _____


☐ Slab ☒ Crawl Space ☐ Basement w/plumbing ☐ Basement wo/plumbing

Water Supply: ☒ Individual ☐ Public ☐ Community

Comments:/Conditions:

Comments:/Conditions:

INITIAL SITE SKETCH

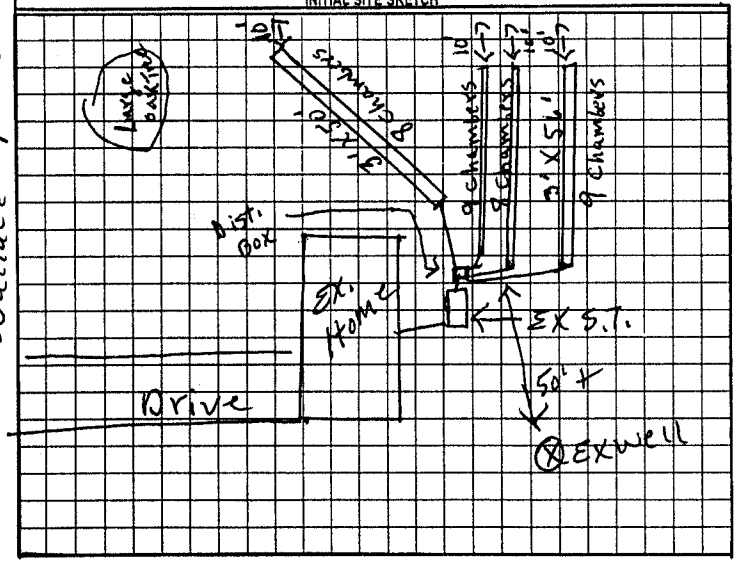

AS BUILT SKETCH

Wallace Sp Rd

Permit can be suspended or revoked if any false information is supplied toward securing the permit/any unauthorized changes are made to the site/any unauthorized changes are made in the installation of the system. Improvement Permit with plat valid without expiration. Improvement Permit with site plan valid for sixty months. Authorization to Construct is valid for a period equal to that of Improvement Permit – not to exceed sixty months.

Signed: X. Kay Payne date _____ Installed by: Joe Tucker

Improvement Permit by: R. C. moore date 1-27-00 Operation Permit by: [signature] RST date 10/26/00

Authorization to Construct by: R. C. moore date 1-27-00 Existing System Inspection by: _____ date _____

HEALTH DEPT. COPY: WHITE OWNER COPY (FINAL): YELLOW OWNER COPY (INITIAL): PINK