11:00

IREDELL COUNTY HEALTH DEPARTMENT

STATESVILLE 704-878-5305 @ MOORESVILLE 704-664-5281

IMPROVEMENT PERMIT / AUTHORIZATION TO CONSTRUCT / OPERATION PERMIT / EXISTING SYSTEM INSPECTION

PERMIT # 162129 PIN # 4722-96-1950 DATE 7-19-10

OWNER or APPLICANT David Reed PHONE: Business 704 528 2265 Home: 704 791 5032

OWNER or APPLICANT ADDRESS 106 Chris Lane

LOCATION / DIRECTIONS Hwy 215 to (R) Old Mth. Rd (R) Wallace Springs

SUBDIVISION Williams Farm BLOCK / SECTION LOT # 41 LOT AREA .955 Ac DESIGN FLOW 480 L.T.A.R. 3

Septic Tank 1000 Gallons: STB 1007 Date 9-26-05

Pump Tank Gallons: P T Date

Pump Make Model Serial #

Nitrification Field No Fields 1 No Lines 5 Linear Feet 400

Trench Width 1 Max. Trench Bottom Depth 20" Gravel Depth n/a

☐ New System ☐ Repair ☒ Expansion System Type I II III IV V VI

System Description: 25% Reduction Gravity

Repair System Description: 25% Reduction Gravity

Maintenance Agreement Required ☐ YES ☒ NO

☒ GRAVITY ☐ PRESSURE


☒ Residence No. Bedrooms 4 ☐ Business No. Persons ☐ Other No. Employees ☐ Slab ☐ Crawl Space ☒ Basement w/plumbing ☐ Basement w/o plumbing

Water Supply: ☒ Private ☐ Public ☐ Community


Comments / Conditions

Comments / Conditions

INITIAL SITE SKETCH

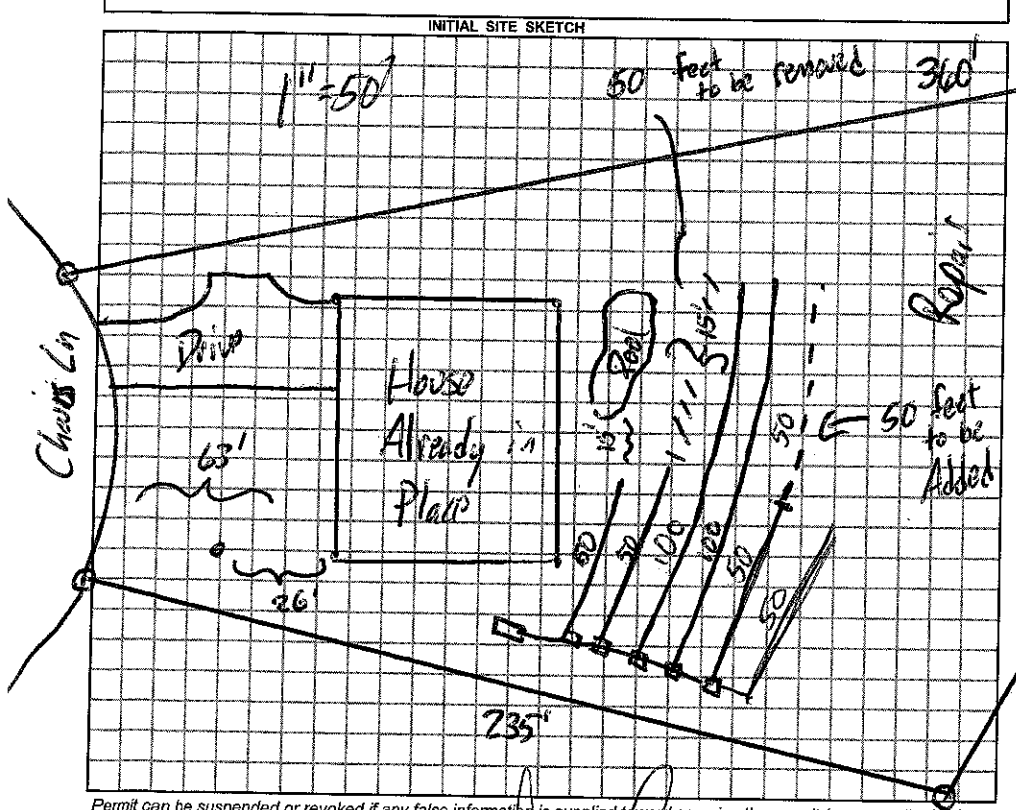

AS BUILT SKETCH

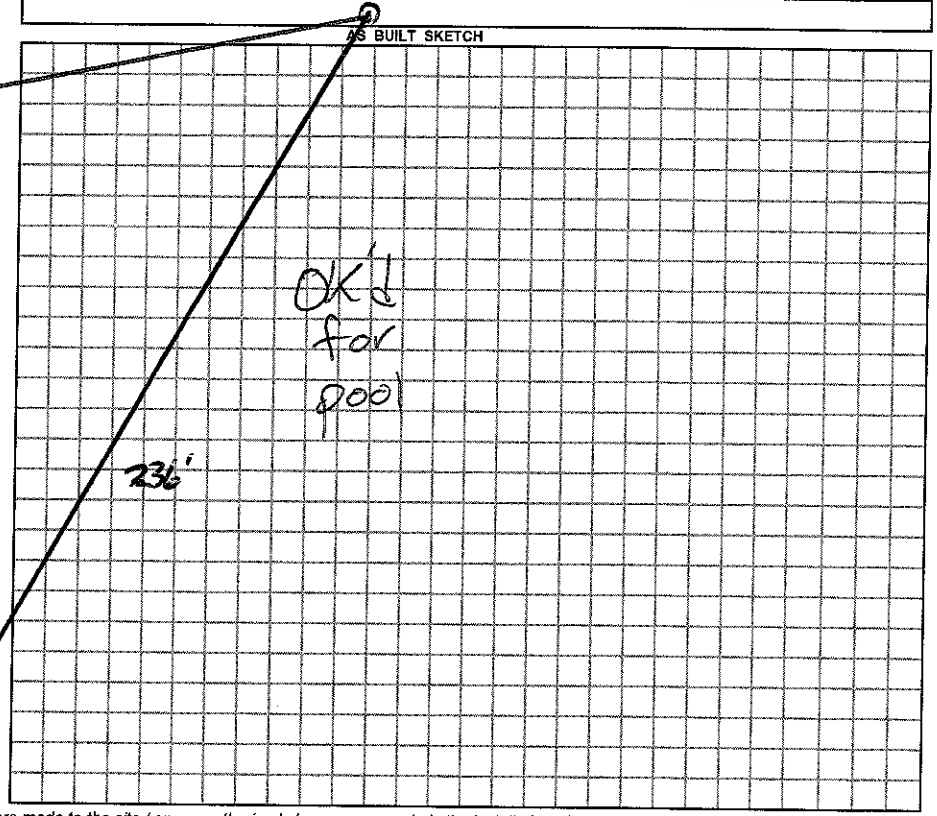

Permit can be suspended or revoked if any false information is supplied toward securing the permit / any unauthorized changes are made to the site / any unauthorized changes are made in the installation of the system.

☐ *IMPROVEMENT PERMIT w / plat valid without expiration.* ☒ *IMPROVEMENT PERMIT w / site plan valid for 60 mos.* ☒ *AUTHORIZATION TO CONSTRUCT valid for period equal to IMPROVEMENT PERMIT-not to exceed 60 mo.*

Owner / Applicant Signature: Date

Improvement Permit by: Date 7-19-10

Authorization to Construct by: Date 7-19-10

Installed by: A-1 Backhoe

Operation Permit by: Date: 7-19-10

Existing System Inspected by: Date:

YOU SHOULD CONTACT A LOCATOR SERVICE PRIOR TO ANY EXCAVATION.

WHITE COPY Environmental Health YELLOW COPY (Final) Owner / Applicant PINK COPY (Initial) Owner / Applicant