IREDELL COUNTY HEALTH DEPARTMENT

STATESVILLE 704-878-5305 MOORESVILLE 704-664-5281

IMPROVEMENT PERMIT / AUTHORIZATION TO CONSTRUCT / OPERATION PERMIT / EXISTING SYSTEM INSPECTION

PERMIT# 089012 PIN# 4722 96 4074 DATE May 22, 00

OWNER OR CONTRACTOR John EAKES PHONE: Business 526-0311 Home

ADDRESS 451 N. MAIN St.

LOCATION Old Mtn. Rd from Troutman TROUTMAN 28166 TR Wallace Springs Rd. TL Chevron TL Shalom on Right

SUBDIVISION Williams FARM BLOCK / SECTION LOT 17 LOT AREA 1.148 Ac SITE CLASS 15 DESIGN FLOW 360gpd L.T.A.R. .3

Septic Tank: 1000 Gallons: STB 854 Date 5/21/00

Pump Tank: Gallons: PT Date

Pump Make: Model Serial No.

Nitrification Field: No Fields 1 Square Feet 900 Linear Feet 300

No Lines 4 Trench Width 36" Max Trench Bottom Depth 36"

☑ New System ☐ Repair System Type: I, II, (III), IV, V, VI

System Description: GRAVITY INNOVATIVE -25% Red.

Repair System Description: pumped INNOV. -25% Red.

Maintenance Agreement Required: ☐ Yes ☑ No

Gravel Depth N/A ☐ Slab ☐ Crawl Space ☐ Basement w/plumbing ☑ Basement wo/plumbing

☑ House/Mod. Home No. Bedrooms 3

☐ Mobile Home No. Bathrooms 2

☐ Business No. Employees


☐ Other

Water Supply: ☐ Individual ☑ Public ☐ Community

Comments/Conditions: @ ONE inspection port per lateral set flush with finished grade. Exit plumbing from main level at ex grade where shown.

Comments/Conditions: SEPTIC TANK WITH RISERS INSTALLED USING "ZABEL" FILTER

INITIAL SITE SKETCH 1"=60'

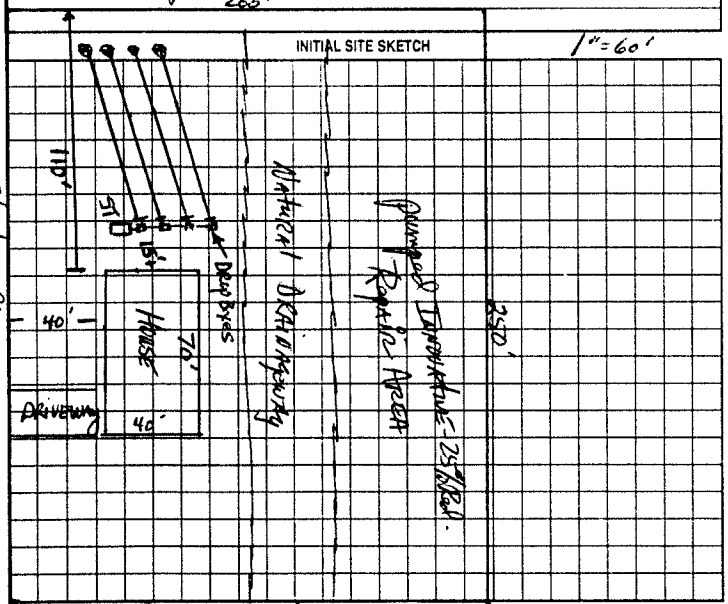

AS BUILT SKETCH

SYSTEM INSTALLED USING "BIODIFFUSER" CHAMBERS ACCORDING TO INITIAL SITE SKETCH

RLW Shalom Place

Permit can be suspended or revoked if any false information is supplied toward securing the permit/any unauthorized changes are made to the site/any unauthorized changes are made in the installation of the system. Improvement Permit with plat valid without expiration. Improvement Permit with site plan valid for sixty months. Authorization to Construct is valid for a period equal to that of Improvement Permit – not to exceed sixty months.

Signed: Date Mellon date 5/25/00

Improvement Permit by: [signature], RS date 5-22-00

Authorization to Construct by: [signature], RS date 5-22-00

Installed by: 9x1 Well boring Const.

Operation Permit by: STEVE HENDRICK date 8-16-00

Existing System Inspection by: date

HEALTH DEPT. COPY: WHITE OWNER COPY (FINAL): YELLOW OWNER COPY (INITIAL): PINK