IREDELL COUNTY HEALTH DEPARTMENT

STATESVILLE 704-878-5305 MOORESVILLE 704-664-5281

IMPROVEMENT PERMIT / AUTHORIZATION TO CONSTRUCT / OPERATION PERMIT / EXISTING SYSTEM INSPECTION

PERMIT# 116957 PIN# 4722-96-4794 5812 DATE

OWNER OR CONTRACTOR KEITH MILLER PHONE: Business 704-902-3764 CELL Home 704-838-0461

ADDRESS 117 AIRPORT ROAD STATESVILLE, NC 28677

LOCATION 21 SOUTH, (R) ONE (R) WALLACE SPRINGS, (L) CHARIS, 6th LOT ON RT, 152 CHARIS LANE

SUBDIVISION Williams Farm BLOCK / SECTION III LOT 43 LOT AREA .913 AC SITE CLASS. DESIGN FLOW 480 L.T.A.R. .3

Septic Tank: 1000 Gallons; STB 3/2 Date 8-8-04

Pump Tank: Gallons; PT Date

Pump Make: Model Serial No.

Nitrification Field: No Fields 1 Square Feet EZ@=1600 Linear Feet 400'

No Lines 3 SPLIT Trench Width 36" Max Trench Bottom Depth 36" Gravel Depth N/A

[X] New System [ ] Repair System Type: I, II, (III), IV, V, VI

System Description: GRAV 25%/6 PRODUCT

Repair System Description: SAME

Maintenance Agreement Required: [ ] Yes [X] No

[X] House/Mod. Home No. Bedrooms 4

[ ] Mobile Home No. Bathrooms 2

[ ] Business No. Employees

[ ] Other

[ ] Slab [ ] Crawl Space [X] Basement w/plumbing [ ] Basement wo/plumbing


Water Supply: [X] Individual [ ] Public [ ] Community

WELL


Comments:/Conditions: (1) INSTALL LINES ON CONTOURS (2) MAINTAIN SETBACKS (3) KEEP WELL 100' FROM ANY PART OF SYSTEM & REPAIR (4) BASEMENT DAYLIGHT END; DO NOT CUT, LEAVE AT NATURAL

Comments:/Conditions: GRADE & DIG INTO HILL FOR THE BASEMENT; LABEL FILTER MANIFOLD

INITIAL SITE SKETCH NOT TO SCALE

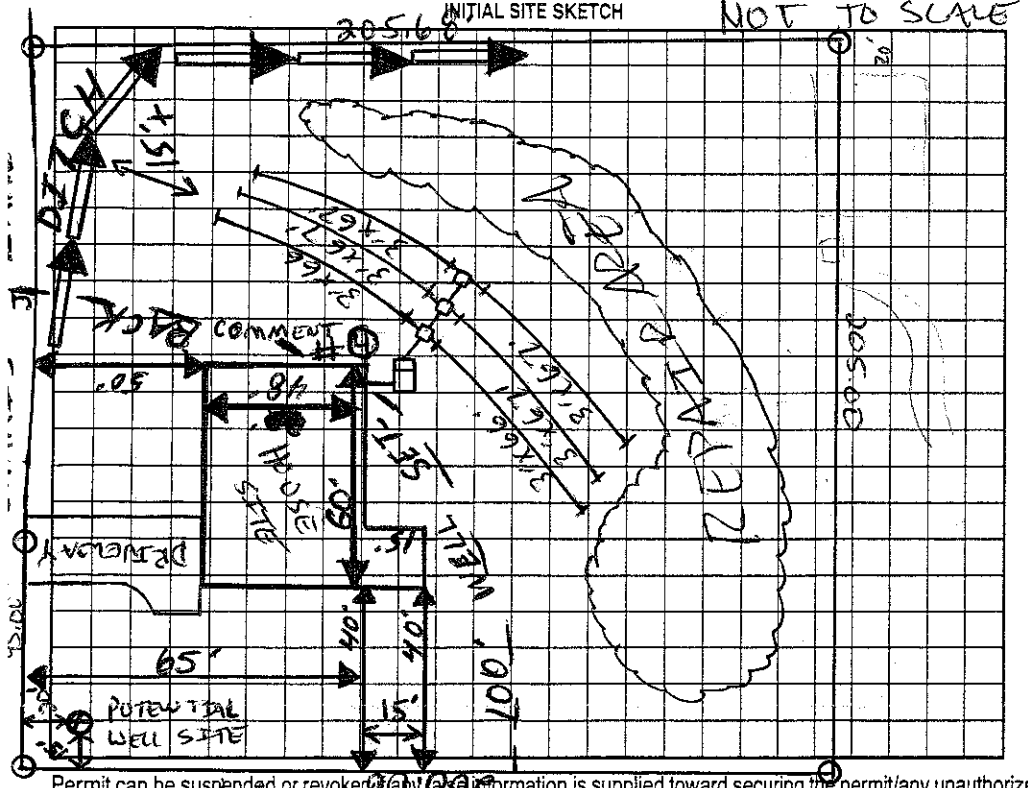

AS BUILT SKETCH

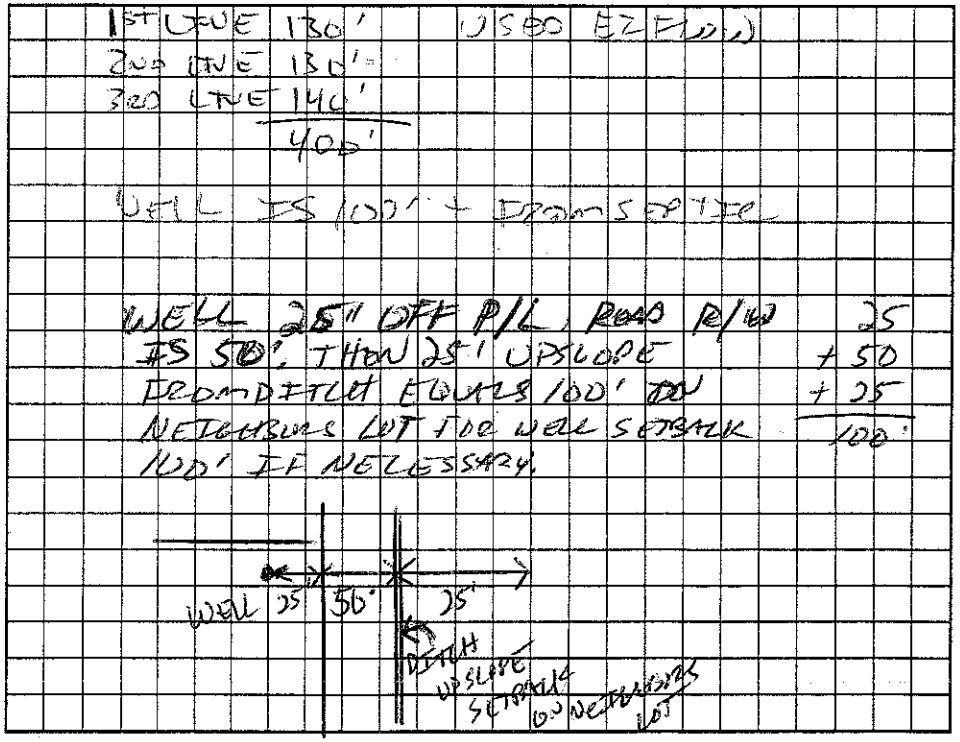

Permit can be suspended or revoked if any false information is supplied toward securing the permit/any unauthorized changes are made to the site/any unauthorized changes are made in the installation of the system. Improvement Permit with plat valid without expiration. Improvement Permit with site plan valid for sixty months. Authorization to Construct is valid for a period equal to that of Improvement Permit – not to exceed sixty months.

Signed: date 12/30/03 Installed by: DELTA GRADING

Improvement Permit by: date 12-9-03 Operation Permit by: date 9-15-04

Authorization to Construct by: date 12-30-03 Existing System Inspection by: date

HEALTH DEPT. COPY: WHITE OWNER COPY (FINAL): YELLOW OWNER COPY (INITIAL): PINK