IREDELL COUNTY HEALTH DEPARTMENT

STATESVILLE 704-878-5305 MOORESVILLE 704-664-5281

IMPROVEMENT PERMIT / AUTHORIZATION TO CONSTRUCT / OPERATION PERMIT / EXISTING SYSTEM INSPECTION

(A)

PERMIT# 110147 PIN# 4722-96-6653 DATE 12-11-02

OWNER OR CONTRACTOR KEITH MILLER PHONE: Business 704-902-3764 Home 704-838-0461

ADDRESS 117 AIRPORT ROAD, STATESVILLE NC 28677

LOCATION WALLACE SPRINGS ROAD TO CHRIS LANE, 5TH LOT ON RIGHT

SUBDIVISION WILLIAMS FARM BLOCK / SECTION 3 LOT 32 LOT AREA 1.033 ACRES SITE CLASS. PS DESIGN FLOW 480 L.T.A.R. 0.40 GPD/FT²

Septic Tank: 1000 Gallons; STB 760 Date 01/03/03
Pump Tank: ____ Gallons; PT ____ Date ____
Pump Make: ____ Model ____ Serial No. ____
Nitrification Field: No Fields 1 Square Feet 1200 Linear Feet 400
No Lines FIVE Trench Width 36" Max Trench Bottom Depth 36" Gravel Depth 12"

☑ New System ☐ Repair System Type: I, II, III, IV, V, VI
System Description: CONVENTIONAL, GRAVITY
Repair System Description: 50% REDUCTION, GRAVITY
Maintenance Agreement Required: ☐ Yes ☑ No


☑ House/Mod. Home No. Bedrooms 3
☐ Mobile Home No. Bathrooms 2½
☐ Business No. Employees ____
☐ Other W/ BONUS ROOM
☐ Slab ☐ Crawl Space ☐ Basement w/plumbing ☑ Basement wo/plumbing

Water Supply: ☑ Individual ☐ Public ☐ Community WELL

Comments:/Conditions: KEEP SYSTEM MINIMUM 100 FEET FROM WELL

Comments:/Conditions: - SEPTIC TANK INSTALLED USING ZABEL FILTER

INITIAL SITE SKETCH

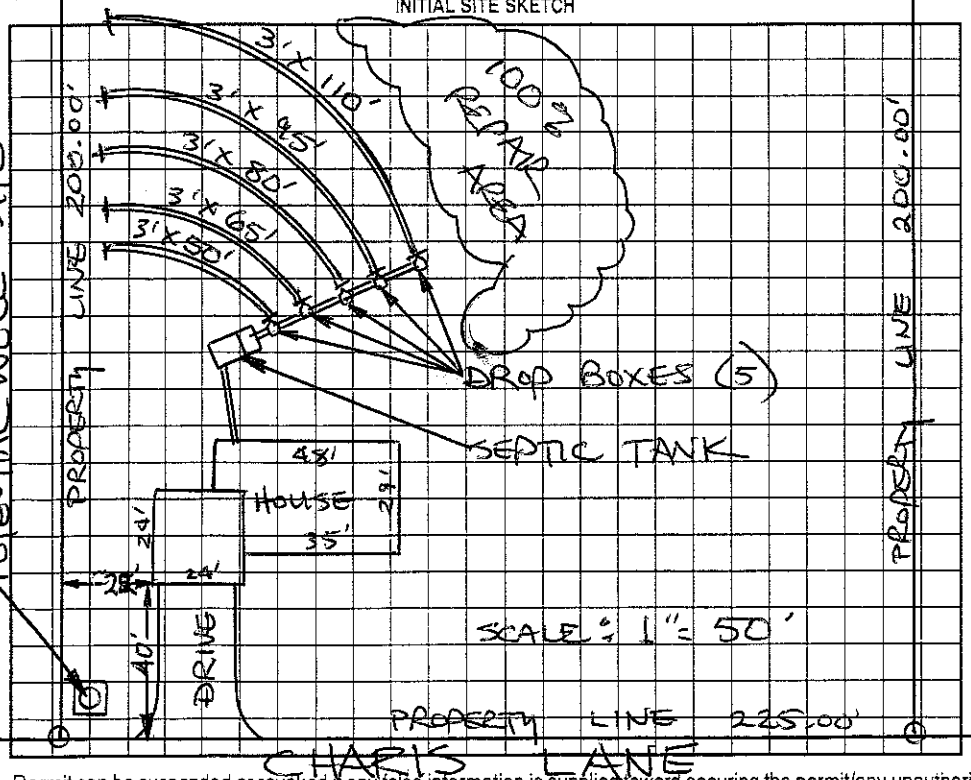

AS BUILT SKETCH

* SYSTEM INSTALLED AS SHOWN IN INITIAL SITE SKETCH.

Permit can be suspended or revoked if any false information is supplied toward securing the permit/any unauthorized changes are made to the site/any unauthorized changes are made in the installation of the system. Improvement Permit with plat valid without expiration. Improvement Permit with site plan valid for sixty months. Authorization to Construct is valid for a period equal to that of Improvement Permit – not to exceed sixty months.

Signed: K Miller date 12/11/02 Installed by: JAKE MILLER

Improvement Permit by: STEVE HEDRICK date 12-11-02 Operation Permit by: Patrick Mitchell date 05/02/03

Authorization to Construct by: STEVE HEDRICK date 12-11-02 Existing System Inspection by: ____ date ____

HEALTH DEPT. COPY: WHITE OWNER COPY (FINAL): YELLOW OWNER COPY (INITIAL): PINK