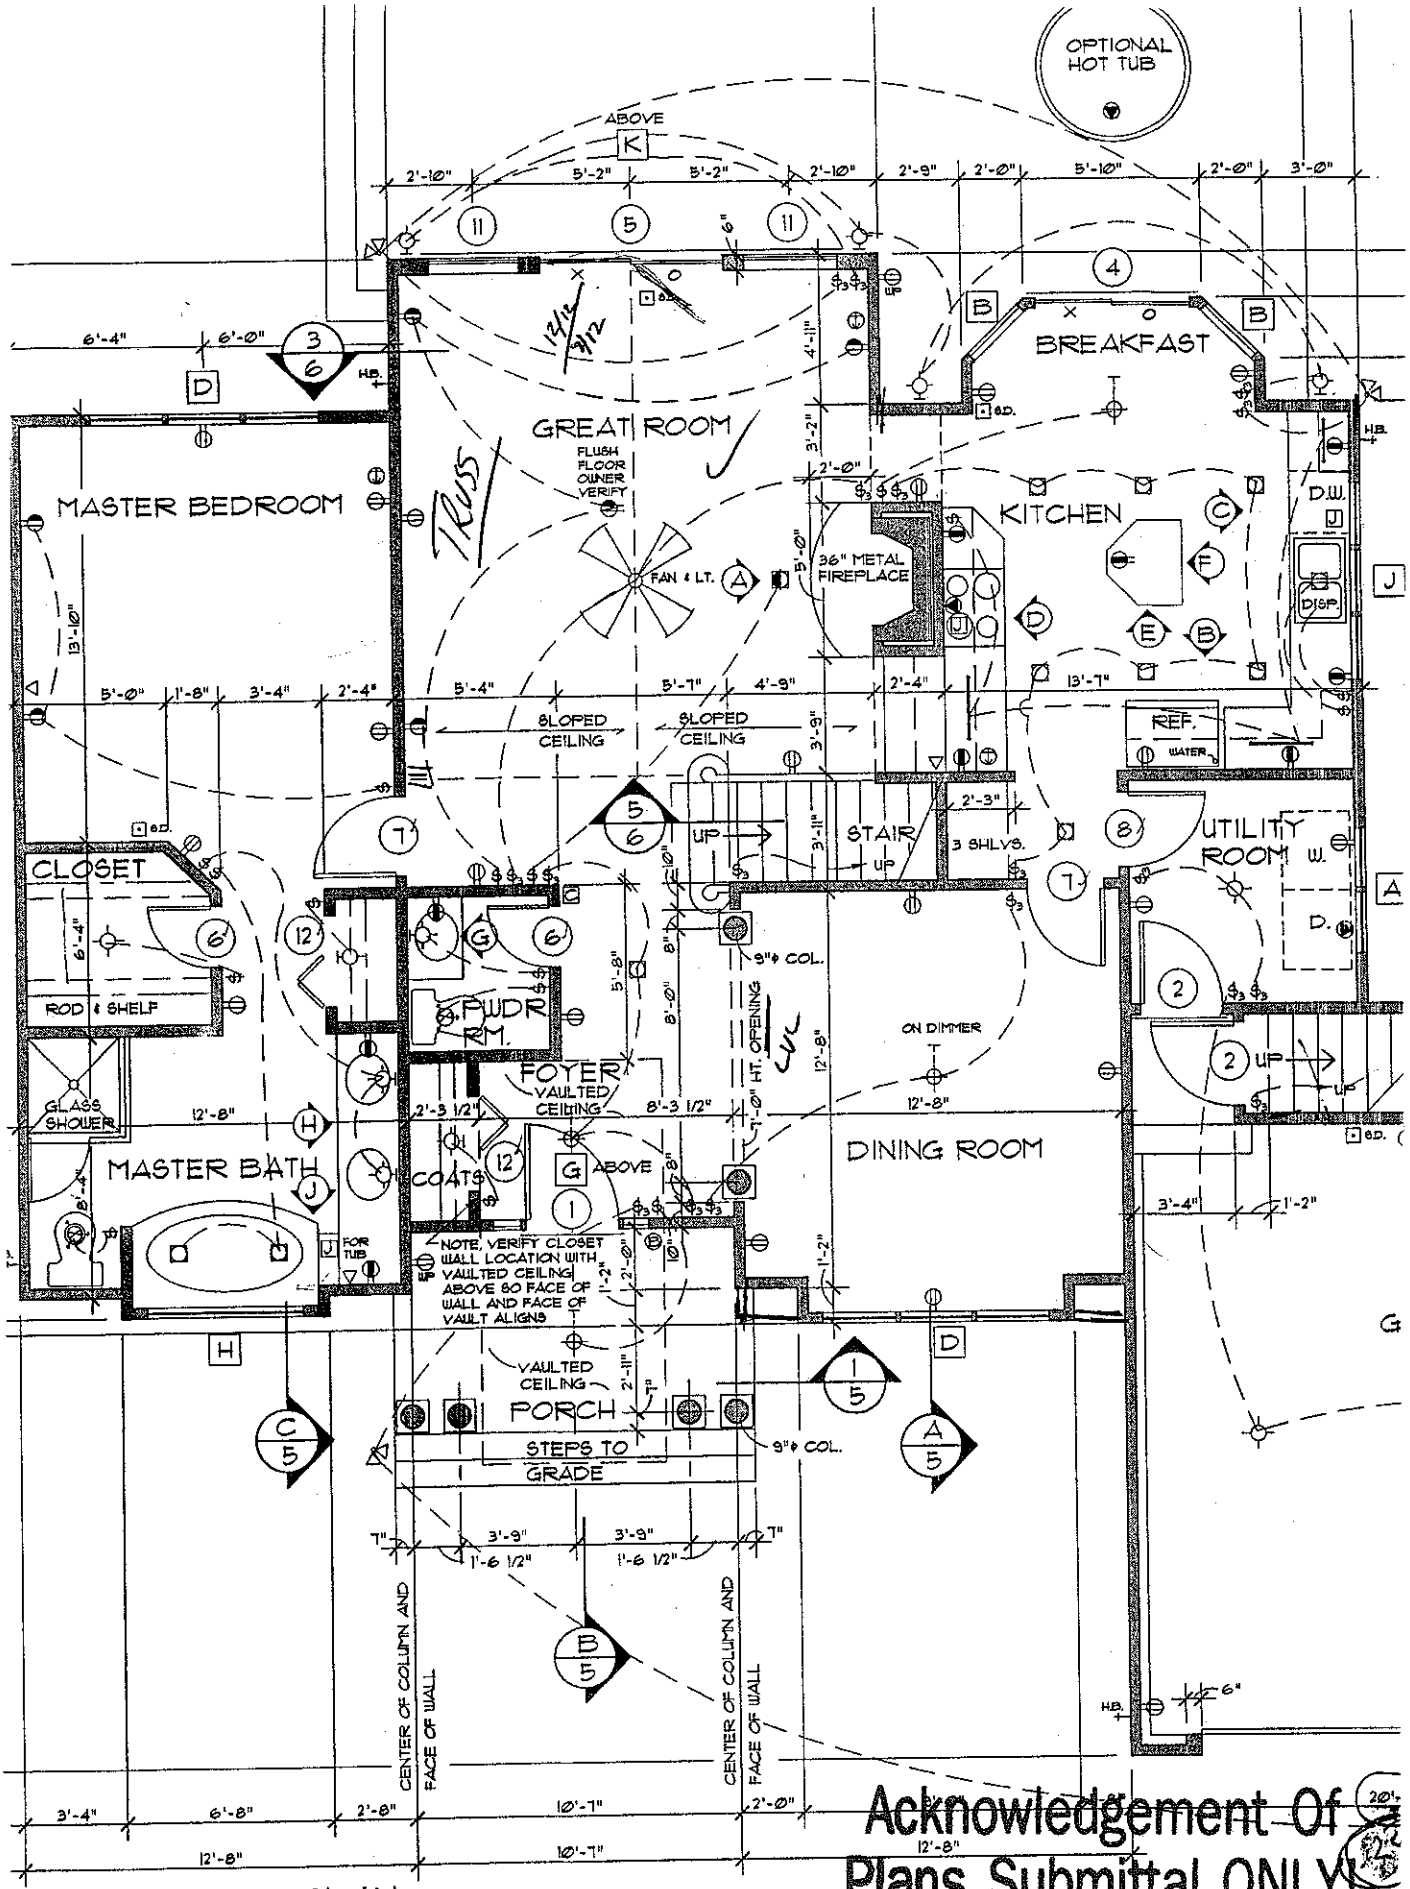


FIRST FLOOR PLAN

1/4" = 1'-0"

SECOND FLOOR	410 sq.ft.
FIRST FLOOR	1288 sq.ft.
TOTAL LIVING	1698 sq.ft.
GARAGE & STORAGE	494 sq.ft.
BONUS ROOM	289 sq.ft.

NOTE, SEE STRUCTURAL DRAWINGS FOR ADDITIONAL INFORMATION

TYPICAL WALL, 2X4'S @ 16" O.C. UNLESS OTHERWISE DIMENSIONED

Acknowledgement Of Plans Submittal ONLY!

STEVE HEDRICK Date 12-9-02

Keith Miller Date 12/10/02

ONT ELEVATION FOR SIDELIGHTS AND TRANSOM.
R DOOR (WITH SIDELIGHTS) AND WINDOW ABOVE.
OR LARGE SCALE ENTRY DETAIL

SCHEDULE


SYMBOL

N'G	DESCRIPTION	PELLA NO.	QUAN.
/8"	CASEMENT	2036 WC2	1
8"	CASEMENT	2068 WC	2
/8"	CASEMENT	2454 WC3	2
/8"	CASEMENT	2460 WC3	2
5/8"	CASEMENT	2442 WC2	1
3/8"	CIRCLEHEAD	CH24 WC2	2
	CIRCLEHEAD	SPECIAL	1
3/8"	PICTURE, FIXED	5448 WC	1
5/8"	CASEMENT	2036 WC3	1
	CIRCLEHEAD	CHTIWDR	1

D FRONT ELEVATION FOR DOOR AND WINDOW ABOVE
3 FOR DOOR (WITH SIDELIGHTS) AND WINDOW ABOVE

SULATED AND WEATHERSTRIPPED AS MANUFACTURED BY
EN CO., PELLA, IOWA 50211)
SS WINDOW REQUIREMENTS PRIOR TO CONSTRUCTION
EL NUMBERS AND SIZES WITH MANUFACTURER BEFORE STARTING CONSTRUCTION

RECESSED DIRECTIONAL CEILING LIGHT FIXTURE
RECESSED CEILING LIGHT FIXTURE
ONE TUBE UNDER COUNTER FLUORESCENT LIGHT
EXTERIOR CAST ALUMINUM FLOOD LIGHTS
CEILING MOUNTED FAN - PADDLE
CEILING MOUNTED FAN - EXHAUST
CEILING MOUNTED FAN AND HEATER
PORCELAIN LAMPHOLDER
DOOR BELL BUTTON
S.D. SMOKE DETECTOR
CEILING MOUNTED FAN, LIGHT, AND HEATER

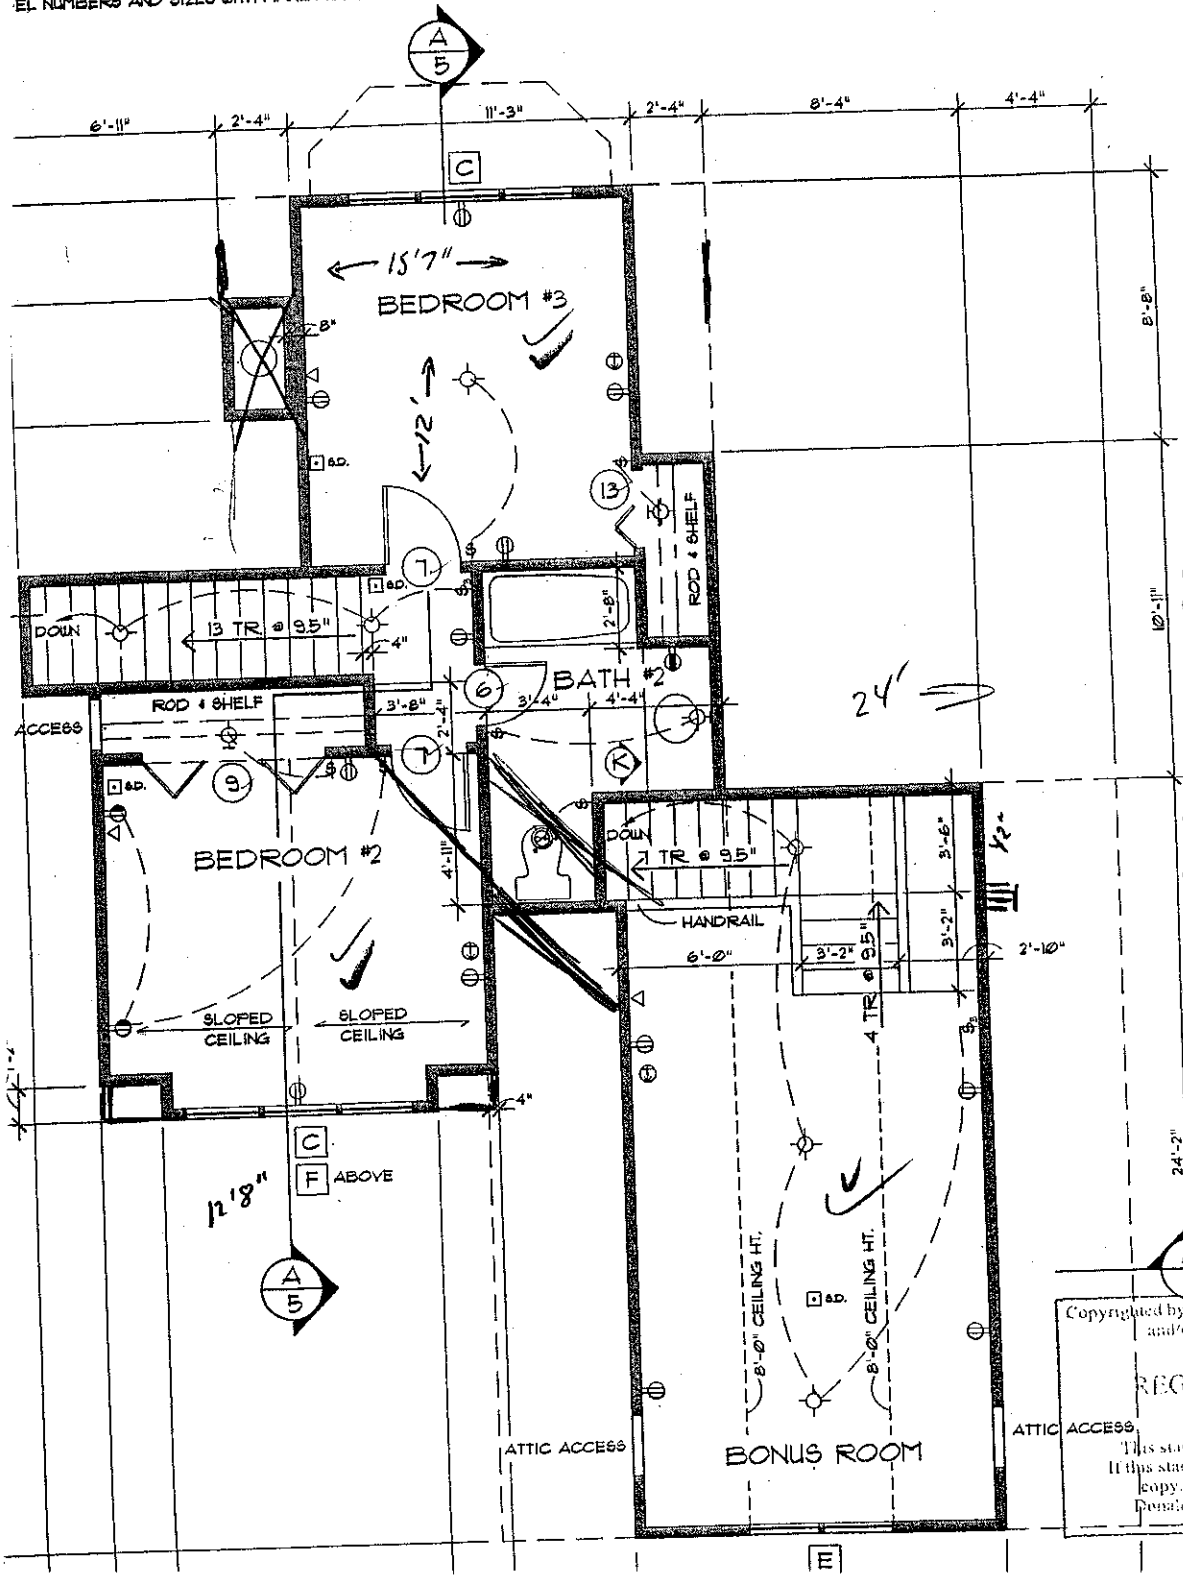

Acknowledgement Of Plans Submittal ONLY!

STEVE HEDRICK Date 12-9-02

Date 12/10/02

RED INK

Copyrighted by Donald A Gardner Architects and/or Donald A Gardner Inc.

REG.#

This stamp must appear in RED INK. If this stamp is not in red, this is an illegal copy. Report this illegal copy to Donald A Gardner, Architects, Inc 1-800 388 2580

RED INK