IREDELL COUNTY HEALTH DEPARTMENT

STATESVILLE 704-878-5305 MOORESVILLE 704-664-5281

IMPROVEMENT PERMIT / AUTHORIZATION TO CONSTRUCT / OPERATION PERMIT / EXISTING SYSTEM INSPECTION

PERMIT# 9245 PIN# 4722 96 6980 PT DATE 10/9/00

OWNER OR CONTRACTOR David Meehan, INC PHONE: Business 704 528-6378 Home

ADDRESS 105 Galax Dr Statesville NC 28677

LOCATION Old MT, L Wallace Springs, L Chairs, on corner of Shalom

SUBDIVISION Williams Farm BLOCK / SECTION LOT 8 LOT AREA .73 AC SITE CLASS PS DESIGN FLOW 360 L.T.A.R. C-3

Septic Tank: 1000 Gallons; STB 1007 Date 9/26/00
Pump Tank: Gallons; PT Date
Pump Make: Model Serial No.
Nitrification Field: No Fields 1 Square Feet 1200 Linear Feet 400
No Lines 4 @ 100' Trench Width 36" Max Trench Bottom Depth 36"

[X] New System [ ] Repair System Type: I, II, III, IV, V, VI
System Description: Grav. Conv.
Repair System Description: Grav. 25% Red.
Maintenance Agreement Required: [ ] Yes [X] No
Gravel Depth 12"


[X] House/Mod. Home No. Bedrooms 3
[ ] Mobile Home No. Bathrooms 2.5
[ ] Business No. Employees
[ ] Other
[ ] Slab [X] Crawl Space [ ] Basement w/plumbing [ ] Basement wo/plumbing

Water Supply: [X] Individual [ ] Public [ ] Community


Comments/Conditions:

Comments/Conditions:

INITIAL SITE SKETCH

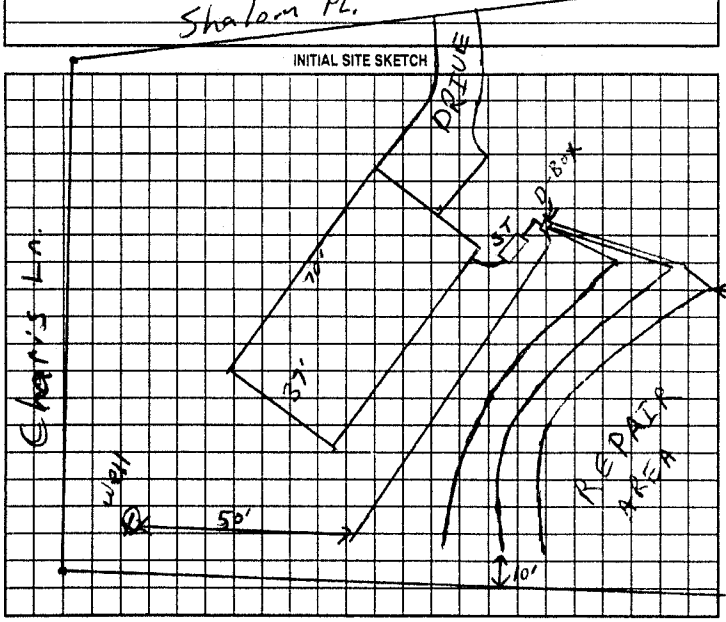

AS BUILT SKETCH

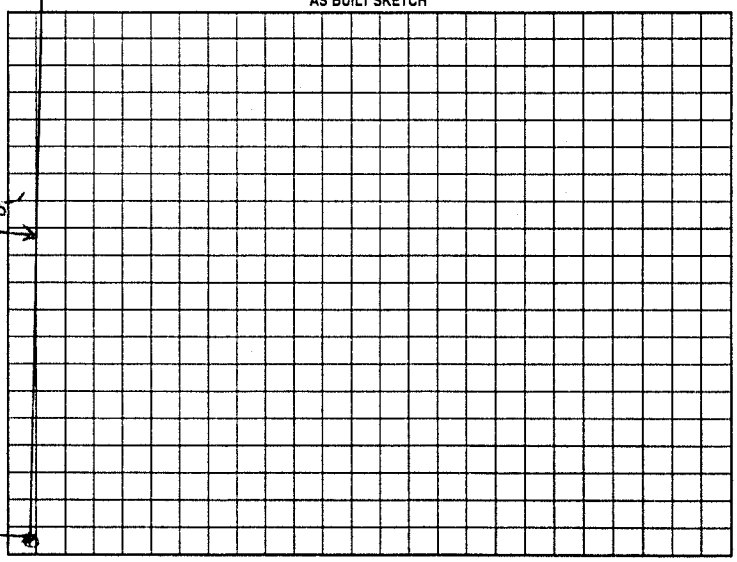

Permit can be suspended or revoked if any false information is supplied toward securing the permit/any unauthorized changes are made to the site/any unauthorized changes are made in the installation of the system. Improvement Permit with plat valid without expiration. Improvement Permit with site plan valid for sixty months. Authorization to Construct is valid for a period equal to that of Improvement Permit – not to exceed sixty months.

Signed: David Meehan date

Improvement Permit by: RSI date 10/9/00

Authorization to Construct by: RSI date 10/9/00

Installed by: Advanced Backhoe

Operation Permit by: RSI date 11/14/00

Existing System Inspection by: date

HEALTH DEPT. COPY: WHITE OWNER COPY (FINAL): YELLOW OWNER COPY (INITIAL): PINK