IREDELL COUNTY HEALTH DEPARTMENT - *ENVIRONMENTAL HEALTH* ☒ STATESVILLE OFFICE 704-878-5305 ☐ MOORESVILLE OFFICE 704-664-5281

IMPROVEMENT PERMIT / AUTHORIZATION TO CONSTRUCT / OPERATION PERMIT / EXISTING SYSTEM INSPECTION

PERMIT # 1106919 PIN # 4722968458 DATE 6-21-11

OWNER Robert Sherrill APPLICANT: PHONE: Home/Cell # 704 528 4079 Business # 704-252-1223

SITE ADDRESS 128 Charis Lane OWNER / APPLICANT ADDRESS

SITE DIRECTIONS Off I-40 to (S) on Old Mtn. (L) on Wallace Springs (L) on Charis Ln 128 on (R)

SUBDIVISION Williams Farm BLOCK / SECTION LOT # 6 LOT AREA 1.69 DESIGN FLOW 360 L.T.A.R. 3

Septic Tank ex Gallons: STB Date

Pump Tank Gallons: P T Date

Pump Make Model Serial #

No. Nitrification Fields: ex No. Lines ex Linear Feet ex

Trench Width ex Max. Trench Bottom Depth ex Gravel Depth n/a

☐ New System ☐ Repair ☐ Expansion System Type I II (III) IV V VI

System Description: 25% Reduction Gravity

Repair System Description: 50% LTAR

Maintenance Agreement Required ☐ YES ☒ NO

☒ GRAVITY ☐ PRESSURE

☒ Residence No. Bedrooms 3

☐ Business No. Persons

☐ Other No. Employees

☐ Slab ☐ Crawl Space


☐ Basement w/plumbing ☐ Basement w/o plumbing

Water Supply: ☒ Private ☐ Public ☐ Community

Comments / Conditions

INITIAL SITE SKETCH

AS BUILT SKETCH 1"=50'

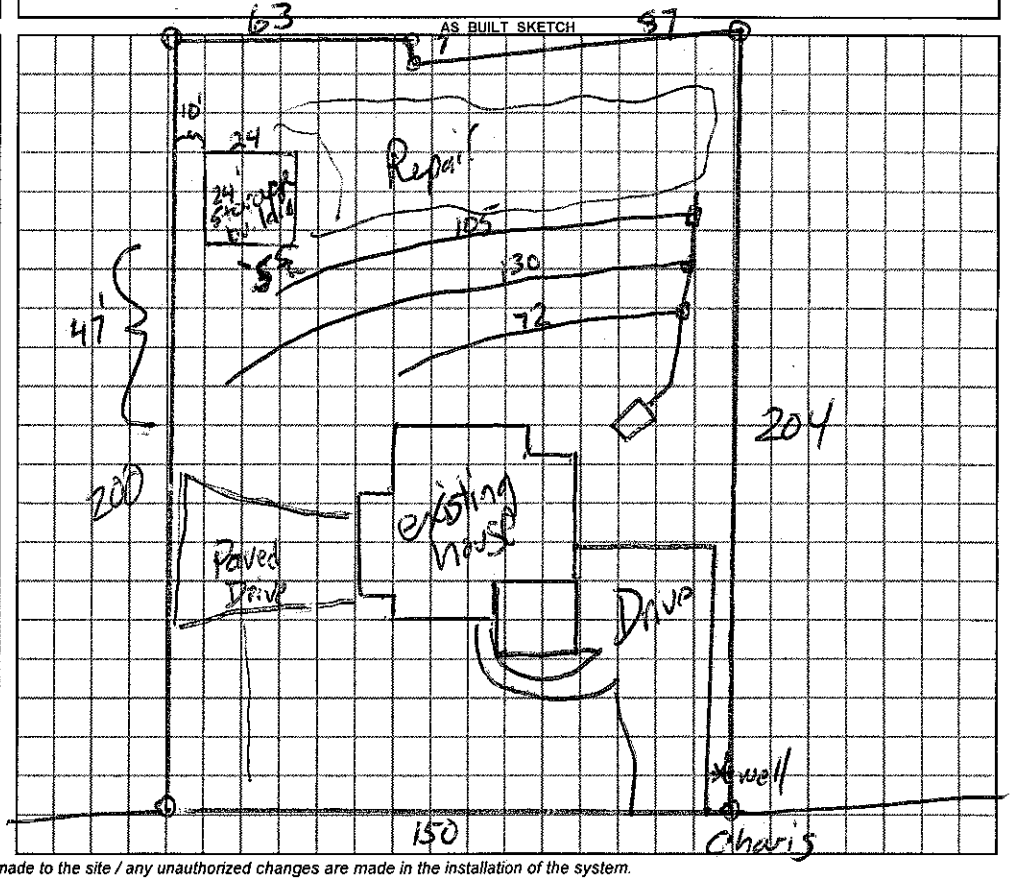

Permit can be suspended or revoked if any false information is supplied toward securing the permit / any unauthorized changes are made to the site / any unauthorized changes are made in the installation of the system.

☐ ***IMPROVEMENT PERMIT*** with plat valid without expiration ☐ ***IMPROVEMENT PERMIT*** with ~~plat~~ valid without expiration. site plan valid 60 mo. ☐ ***AUTHORIZATION TO CONSTRUCT*** valid for period equal to IMPROVEMENT PERMIT–not to exceed 60 mo.

Owner / Applicant Signature: Robert Sherrill Date 6-21-11 Installed by:

IMPROVEMENT PERMIT by: ***REHS*** Date OPERATION PERMIT by: ***REHS*** Date

AUTHORIZATION TO CONSTRUCT by: ***REHS*** Date Existing System Inspected by: ***REHS*** Date 6-21-11

YOU SHOULD CONTACT A LOCATOR SERVICE PRIOR TO ANY EXCAVATION

White Copy – Environmental Health YELLOW COPY (Final) Owner / Applicant PINK COPY (Initial) Owner / Applicant