IREDELL COUNTY HEALTH DEPARTMENT

STATESVILLE 704-878-5305 MOORESVILLE 704-664-5281

IMPROVEMENT PERMIT / AUTHORIZATION TO CONSTRUCT / OPERATION PERMIT / EXISTING SYSTEM INSPECTION

PERMIT# 83980 PIN# 4722716980 DATE Jan 11 2000

OWNER OR CONTRACTOR Tommy Williams PHONE: Business Home 825264 0273

ADDRESS 9476 Hwy 194 N Todd NC

LOCATION Old mt Rd 5th (L) Wallace Springs (L) Chars Lane Wallace Springs Lt 5 on Right

SUBDIVISION Wallace Springs BLOCK / SECTION LOT 5 LOT AREA .73 SITE CLASS IV DESIGN FLOW 360 L.T.A.R. .3

Septic Tank: 1000 Gallons; STB 760 Date 04/30/02
Pump Tank: Gallons; PT Date
Pump Make: Model Serial No.
Nitrification Field: No Fields 1 Square Feet 1200 Linear Feet 300
No Lines 4 @ 75 Trench Width 36" Max Trench Bottom Depth 36"

☒ New System ☐ Repair System Type: I, II, III, IV, V, VI
System Description: Gravity 25% Reduction
Repair System Description: Same / Panel Block
Maintenance Agreement Required: ☐ Yes ☒ No Possible
Gravel Depth N/A
☐ Slab ☐ Crawl Space ☐ Basement w/plumbing ☒ Basement wo/plumbing


☒ House/Mod. Home No. Bedrooms 3
☐ Mobile Home No. Bathrooms 2
☐ Business No. Employees
☐ Other

Water Supply: ☒ Individual ☐ Public ☐ Community
WELL

Comments/Conditions: INSTALL on CONTOUR
50 Chambers OR 30 HDS Sections

Comments/Conditions. ① SEPTIC TANK INSTALLED WITH ZABEL FILTER & SEPTIC TANK MARKER

INITIAL SITE SKETCH

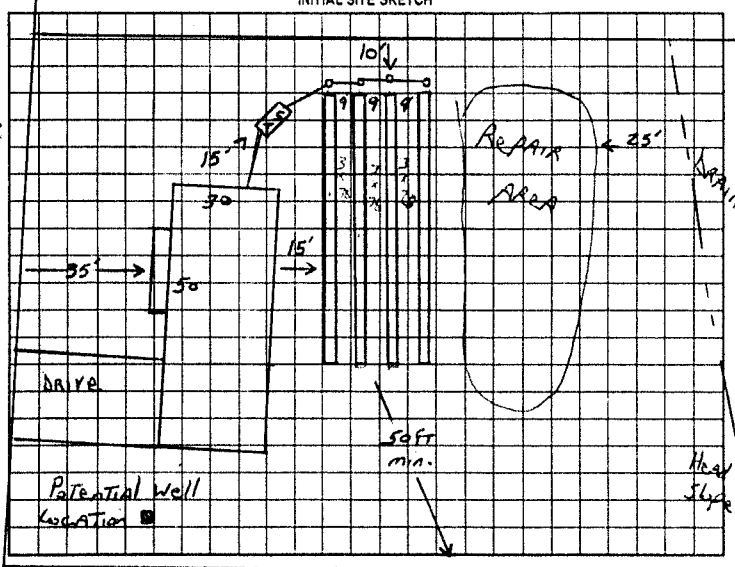

Chars Lane

AS BUILT SKETCH

SYSTEM INSTALED AS SHOWN IN INITIAL SITE SKETCH

Permit can be suspended or revoked if any false information is supplied toward securing the permit, any unauthorized changes are made to the site, any unauthorized changes are made in the installation of the system. Improvement Permit with plat valid without expiration. Improvement Permit with site plan valid for sixty months. Authorization to Construct is valid for a period equal to that of Improvement Permit – not to exceed sixty months.

Signed: date 1-12-00 Installed by: Miller Construction

Improvement Permit by: date Jan 11 2000 Operation Permit by: date 08/07/02

Authorization to Construct by: date Jan 11 2000 Existing System Inspection by: date

HEALTH DEPT. COPY: WHITE OWNER COPY (FINAL): YELLOW OWNER COPY (INITIAL): PINK