IREDELL COUNTY HEALTH DEPARTMENT

STATESVILLE 704-878-5305 MOORESVILLE 704-664-5281

IMPROVEMENT PERMIT / AUTHORIZATION TO CONSTRUCT / OPERATION PERMIT / EXISTING SYSTEM INSPECTION

PERMIT# REPAR PIN# 4723-00-0086 DATE 1-28-02

OWNER OR CONTRACTOR MARIE G. HOUSTON PHONE: Business Home (704) 528-6604

ADDRESS 109 MARIE DUKE LANE, STATESVILLE NC 28677

LOCATION I-40 WEST TL OLD MTN. RD, TR MARIE DUKE LN, 1ST HOUSE ON LEFT

SUBDIVISION BLOCK / SECTION LOT LOT AREA 2 ACRES SITE CLASS. PS DESIGN FLOW 240 L.T.A.R. EXISTING NO.3

Septic Tank: 1000 Gallons, STB 760 Date 10-27-01
Pump Tank: Gallons; PT Date
Pump Make: Model Serial No.
Nitrification Field: No Fields 1 Square Feet 900 Linear Feet 300
No Lines FOUR Trench Width 36" Max Trench Bottom Depth 36" Gravel Depth 12"

☐ New System ☑ Repair System Type: I (II) III IV V VI
System Description: CONVENTIONAL GRAVITY
Repair System Description: CONV. GRAVITY
Maintenance Agreement Required: ☐ Yes ☑ No
☐ Slab ☐ Crawl Space ☑ Basement w/plumbing ☐ Basement wo/plumbing


☑ House/Mod. Home No. Bedrooms 3
☐ Mobile Home No. Bathrooms 2
☐ Business No. Employees
☐ Other

Water Supply: ☑ Individual ☐ Public ☐ Community WELL

Comments:/Conditions: TIE KITCHEN & WASHER DRAINS INTO NEW SYSTEM. THIS PERMIT SERVES AS "NOTICE OF VIOLATION", SYSTEM TO BE REPAIRED BY 2-28-02.

Comments:/Conditions: SEPTIC TANK WITH MARKER INSTALLED USING "ZABEL" FILTER

INITIAL SITE SKETCH

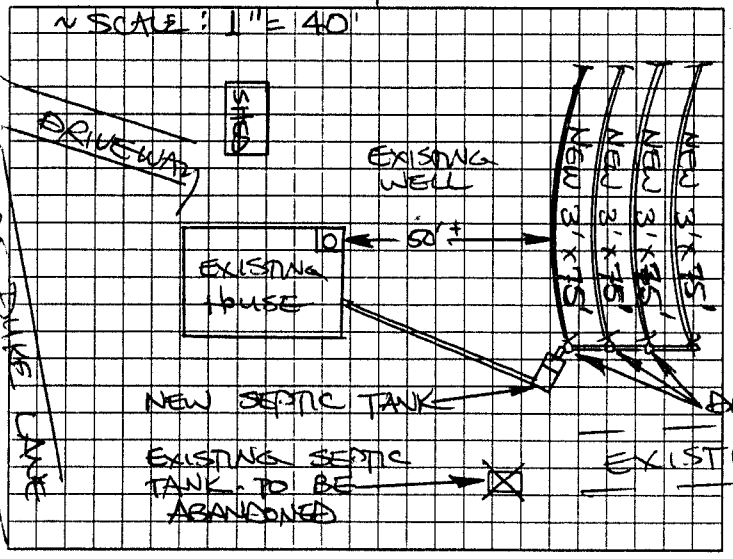

AS BUILT SKETCH

SYSTEM REPAIRED ACCORDING TO INITIAL SITE SKETCH

Permit can be suspended or revoked if any false information is supplied toward securing the permit/any unauthorized changes are made to the site/any unauthorized changes are made in the installation of the system. Improvement Permit with plat valid without expiration. Improvement Permit with site plan valid for sixty months. Authorization to Construct is valid for a period equal to that of Improvement Permit – not to exceed sixty months.

Signed: X [signature] Agent date 1-28-02 Installed by: BARRY SIGMON

Improvement Permit by: STEVE HEDRICK date 1-28-02 Operation Permit by: STEVE HEDRICK date 1-30-02

Authorization to Construct by: STEVE HEDRICK date 1-28-02 Existing System Inspection by: date

HEALTH DEPT COPY: WHITE OWNER COPY (FINAL): YELLOW OWNER COPY (INITIAL): PINK