IREDELL COUNTY HEALTH DEPARTMENT

STATESVILLE 704-878-5305 MOORESVILLE 704-664-5281

IMPROVEMENT PERMIT / CERTIFICATE OF COMPLETION / OPERATION PERMIT / EXISTING SYSTEM INSPECTION

PROPERTY DESCRIPTION NO. 2613 05547 DATE 4-14-97 TAX MAP NO. 4723002559 Watershed: ☐ Yes ☐ No

OWNER OR CONTRACTOR Mark Davidson PHONE: Business _____ Home 528-3331 WSIR PA

ADDRESS 996 Old Mtn Rd Statesville

LOCATION I-40 TL Old Mtn Rd Property (R) Past Spring Meadows Subdivision

SUBDIVISION _____ BLOCK / SECTION _____ LOT _____ LOT AREA 1.06 AC. SITE CLASS. D/S DESIGN FLOW 480 L.T.A.R. 0.3

Septic Tank: 1500 Gallons; STB 797 Date 5-25-97

Pump Tank: _____ Gallons; PT _____ Date _____

Pump Make: _____ Model _____ Serial No. _____

Nitrification Field; No Fields 1 Square Feet 1200 Linear Feet 400

No Lines 6 Trench Width 36in Max Trench Bottom Depth 36in Gravel Depth Sand

☒ New System ☐ Repair System Type: I, II, (III) IV, V, VI

System Description: Graf Chamber

Repair System Description: Infiltrator Chamber

Maintenance Agreement Required: ☐ Yes ☒ No

☐ House/Mod. Home No. Bedrooms 4

☐ Mobile Home No. Bathrooms 2

☐ Business No. Employees ____

☒ Other Duplex


☒ Slab ☐ Crawl Space ☐ Basement w/plumbing ☐ Basement wo/plumbing

Water Supply: ☒ Individual ☐ Community ☐ Public


Comments: Keep well 100 Ft from system
Keep lines on contour 9ft on center, 10Ft from property lines

Comments:

INITIAL SITE SKETCH

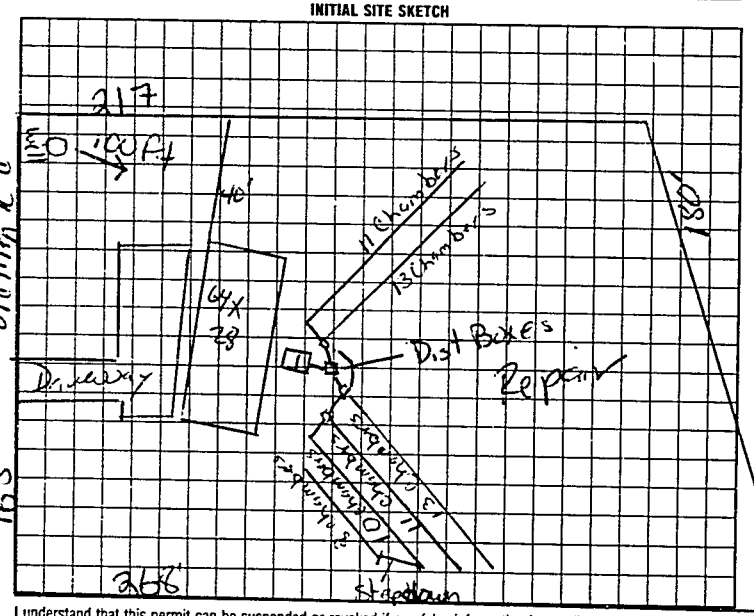

AS BUILT SKETCH

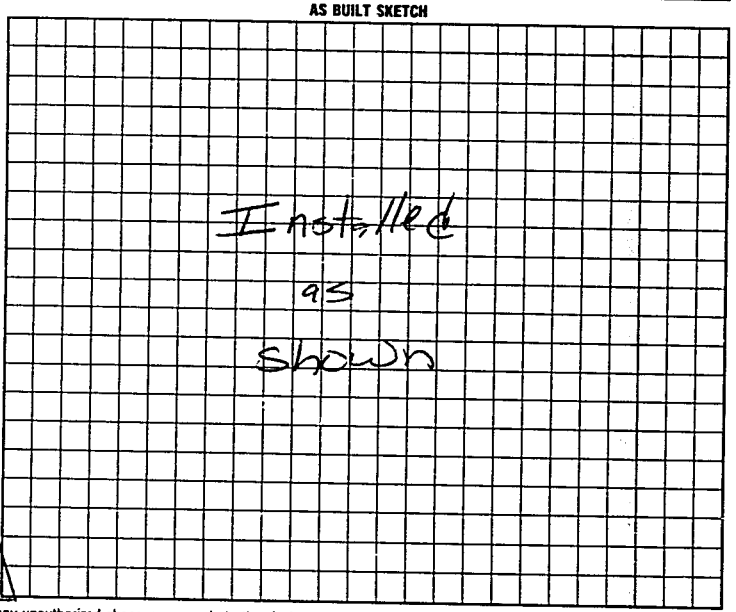

I understand that this permit can be suspended or revoked if any false information is supplied toward securing the permit/any unauthorized changes are made to the site/any unauthorized changes are made in the installation of the system. Improvement Permit is valid for 60 months from date of issuance. Authorization to Construct expires 5 yrs from issue date

Signed: X _____

Improvement Permit by: Mark C Ort RS date 4-14-97

~~Authorization to Const.~~ Existing System Inspection by: Mark C Ort RS date 4-14-97

Installed by: Chris Davidson

Certificate of Completion by: _____ date _____

Operation Permit by: Mark C Ort RS date 7-2-97

HEALTH DEPT COPY: WHITE INSPECTION COPY (FINAL): GREEN OWNER COPY (FINAL): YELLOW INSPECTION COPY (INITIAL): PINK OWNER COPY (INITIAL): GOLD