Nelson Dellinger Contractors

IREDELL COUNTY HEALTH DEPARTMENT

STATESVILLE 704-878-5305 MOORESVILLE 704-664-5281

IMPROVEMENT PERMIT / AUTHORIZATION TO CONSTRUCT / OPERATION PERMIT / EXISTING SYSTEM INSPECTION

FAC 7/28/09

PERMIT # 15764850 PIN # 4723-01-2114 1079 DATE 7/28/09

OWNER or APPLICANT ByNum (Ben) & Susan Ward PHONE: Business 704-528-9650 Home: cell

OWNER or APPLICANT ADDRESS 111 Old Mountain Rd Statesville NC 28677

LOCATION / DIRECTIONS I-77 S to Exit 45 Left to Murdock Rd Cross I-85 N South on Old Mountain Rd on left before Spring Meadows

SUBDIVISION Lot LOT/BLOCK / SECTION Subdivision LOT AREA DESIGN FLOW L.T.A.R.

Septic Tank Existing Gallons: STB Date

Pump Tank 1000 Gallons: PT Date

Pump Make Model Serial #

Nitrification Field No Fields 1 No Lines 2 Linear Feet 250

Trench Width 36" Max. Trench Bottom Depth Gravel Depth 10"

☐ New System ☐ Repair ☐ Expansion System Type I (II) III IV V VI

System Description:

Repair System Description:

Maintenance Agreement Required ☐ YES ☐ NO

☒ GRAVITY ☐ PRESSURE

☐ Residence No. Bedrooms ☐ Business No. Persons ☐ Other No. Employees ☐ Slab ☐ Crawl Space ☐ Basement w/plumbing ☐ Basement w/o plumbing


Water Supply ☒ Private ☐ Public ☐ Community

Comments / Conditions


Existing System, Check 24'X30' SQ 720FT With No plumbing in GARAGE outBuilding

Comments / Conditions

INITIAL SITE SKETCH

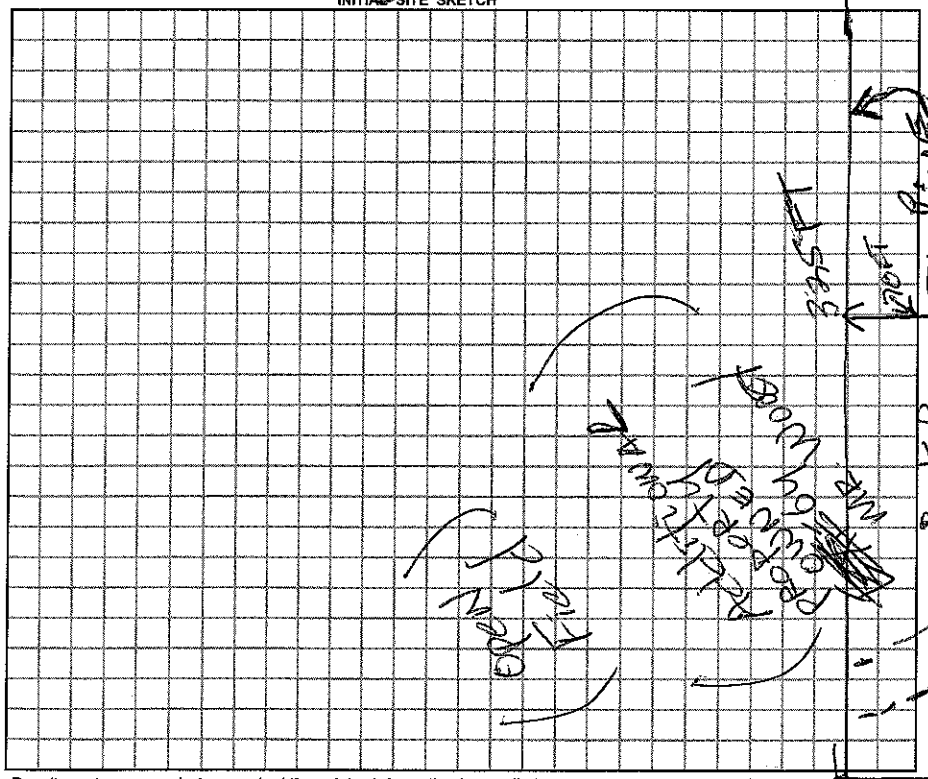

AS BUILT SKETCH

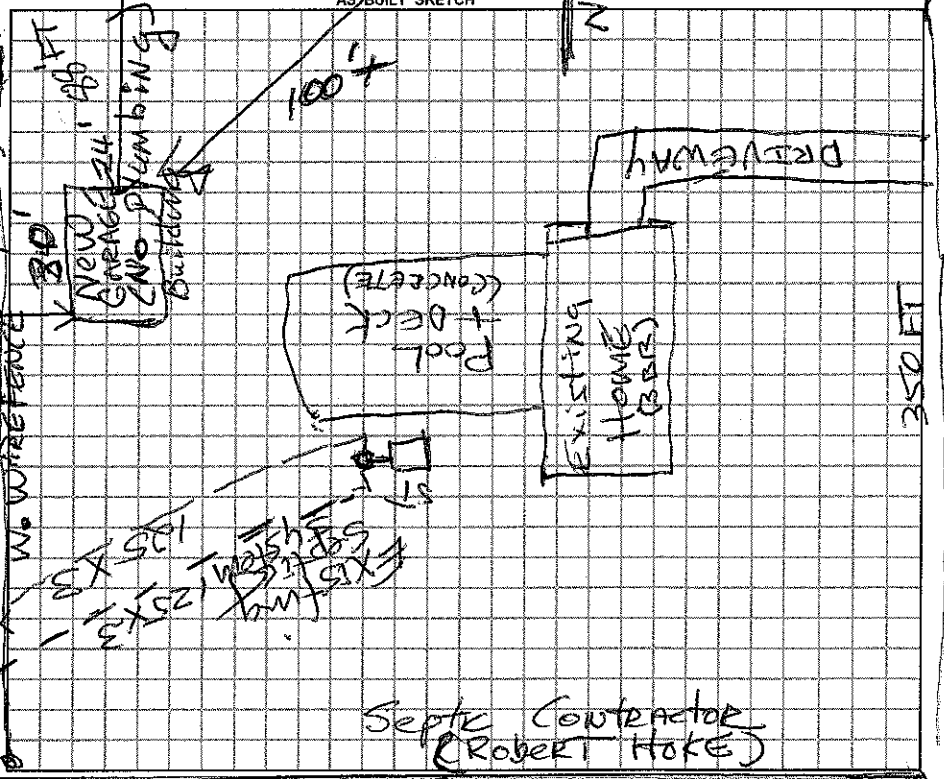

Permit can be suspended or revoked if any false information is supplied toward securing the permit / any unauthorized changes are made to the site / any unauthorized changes are made to the installation of the system.

☐ *IMPROVEMENT PERMIT w / plat valid without expiration.* ☐ *IMPROVEMENT PERMIT w / site plan valid for 60 mos.* ☐ *AUTHORIZATION TO CONSTRUCT valid for period equal to IMPROVEMENT PERMIT-not to exceed 60 mo.*

Owner / Applicant Signature: Date

Improvement Permit by: Date

Authorization to Construct by: Date

YOU SHOULD CONTACT A LOCATOR SERVICE PRIOR TO ANY EXCAVATION.

Installed by: Original System Installed on 9-14-81

Operation Permit by: Checked by Glen FOX, JR Date: 9-14-81

Existing System Inspected by: Jud Clemmer Date: 7-28-09

WHITE COPY Environmental Health YELLOW COPY (Final) Owner / Applicant PINK COPY (Initial) Owner / Applicant