IREDELL COUNTY HEALTH DEPARTMENT

STATESVILLE 704-878-5305 MOORESVILLE 704-664-5281

11:00 56930

IMPROVEMENT PERMIT / CERTIFICATE OF COMPLETION / OPERATION PERMIT / EXISTING SYSTEM INSPECTION

PROPERTY DESCRIPTION NO. 21476 DATE 7-10-95 TAX MAP NO. 8K-9-A-59 Watershed: ☐ Yes ☒ No

OWNER OR CONTRACTOR Kathryn Goodwin PHONE: Business _____ Home 528-3970

ADDRESS 134 max well lane

LOCATION Buffalo Shoals Rd TR Old mtn Rd TR Spring meadows Dr. 2nd lot on left

SUBDIVISION Spring meadows BLOCK / SECTION _____ LOT 59 LOT AREA .1899 acres SITE CLASS. PS DESIGN FLOW 360 L.T.A.R. .3

Septic Tank: 1000 Gallons; STB 794 Date 9-15-95

Pump Tank: 1000 Gallons; PT P727 Date 8-20-95

Pump Make: Gould Model WE05J1HH Serial No. 8953784

Nitrification Field: No Fields 1 Square Feet 300 Linear Feet 400

No Lines 3 Trench Width 36" Max Trench Bottom Depth 24 Gravel Depth 12"

☐ New System ☐ Repair System Type: I, II, III, IV, V, VI

System Description: Pump To conv. lines

Repair System Description: " " Chamberet

Maintenance Agreement Required: ☐ Yes ☐ No Gravelless System

☒ House/Mod. Home No. Bedrooms 3

☐ Mobile Home No. Bathrooms 2

☐ Business No. Employees ____

☐ Other ____

☐ Slab ☒ Crawl Space ☐ Basement w/plumbing ☐ Basement w/o plumbing

Water Supply: ☒ Individual ☐ Community ☐ Public


Comments:

See Attached Sheets for Pump Tank set up + Pressure Manifold set up.


Comments: Inspection

① Inspected manifold + drain lines P.T. + S.T. 10-18-95 JCH

INITIAL SITE SKETCH

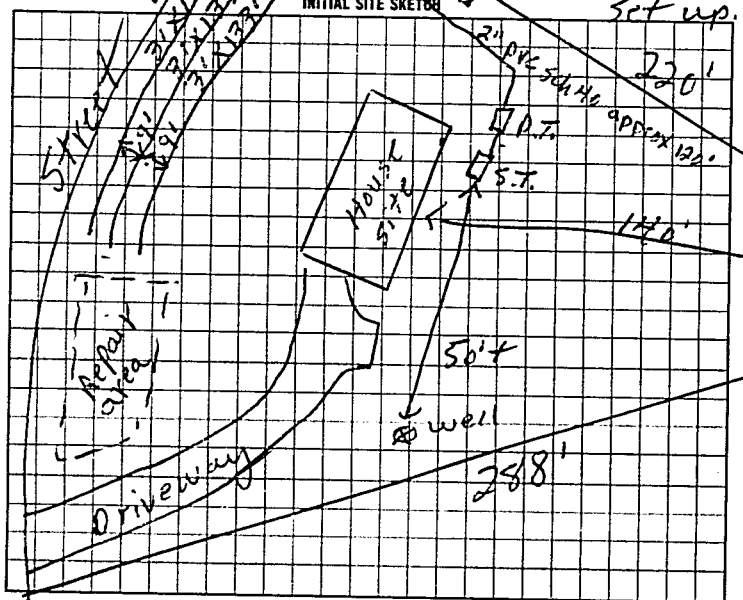

AS BUILT SKETCH

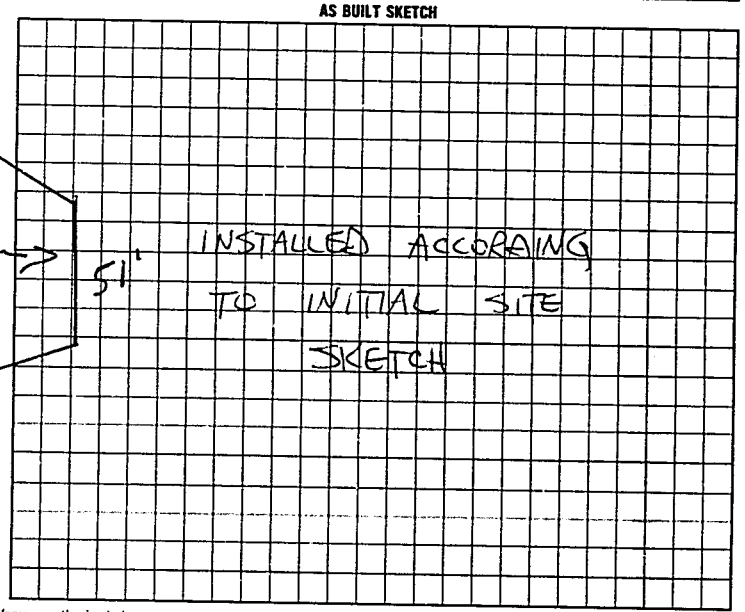

I understand that this permit can be suspended or revoked if any false information is supplied toward securing the permit/any unauthorized changes are made to the site/any unauthorized changes are made in the installation of the system. Improvement Permit is valid for 60 months from date of issuance.

Signed: Kathy Goodwin

Improvement Permit by: P.C. Moore date 7-10-95

Existing System Inspection by: _____ date _____

Installed by: A-1 BACKHOE

Certificate of Completion by: _____ date _____

Operation Permit by: STEVE HENRICK date 1-31-96

HEALTH DEPT. COPY: WHITE INSPECTION COPY (FINAL): GREEN OWNER COPY (FINAL): YELLOW INSPECTION COPY (INITIAL): PINK OWNER COPY (INITIAL): GOLD