IREDELL COUNTY HEALTH DEPARTMENT

IMPROVEMENT PERMIT / CERTIFICATE OF COMPLETION / OPERATION PERMIT / EXISTING SYSTEM INSPECTION

STATESVILLE 704-878-5305 MOORESVILLE 704-664-5281

OP# 7310-9-97

PROPERTY DESCRIPTION NO. 66385 DATE 5-2-97 TAX MAP NO. 4723068941

OWNER OR CONTRACTOR Bobby L Bond PHONE: Business Home 804-648 7493

ADDRESS 2822 Seibel Road Richmond VA Watershed: ☐ Yes ☐ No

LOCATION 70 West TL Airport Rd TR Fleetwood Nearest on left

SUBDIVISION BLOCK / SECTION LOT LOT AREA 100'X125' SITE CLASS: PS DESIGN FLOW L.T.A.R. 1,3

Septic Tank: 1000 Gallons; STB 1012 Date 2-9-98

Pump Tank: Gallons; PT Date

Pump Make: Model Serial No.

Nitrification Field: No Fields 1 Square Feet 400 Linear Feet 200

No Lines 3 Trench Width 24 Max Trench Bottom Depth 36" Gravel Depth N/A

☑ New System ☐ Repair System Type: I, II, III, IV, V, VI

System Description: Gravity Panel

Repair System Description:

Maintenance Agreement Required: ☐ Yes ☑ No

☐ House/Mod. Home No. Bedrooms 3

☐ Mobile Home No. Bathrooms 2

☐ Business No. Employees

☐ Other

☐ Slab ☑ Crawl Space ☐ Basement w/plumbing ☐ Basement wo/plumbing


Water Supply: ☐ Individual ☐ Community ☑ Public

Comments:


100' Fleetwood

125'

INITIAL SITE SKETCH

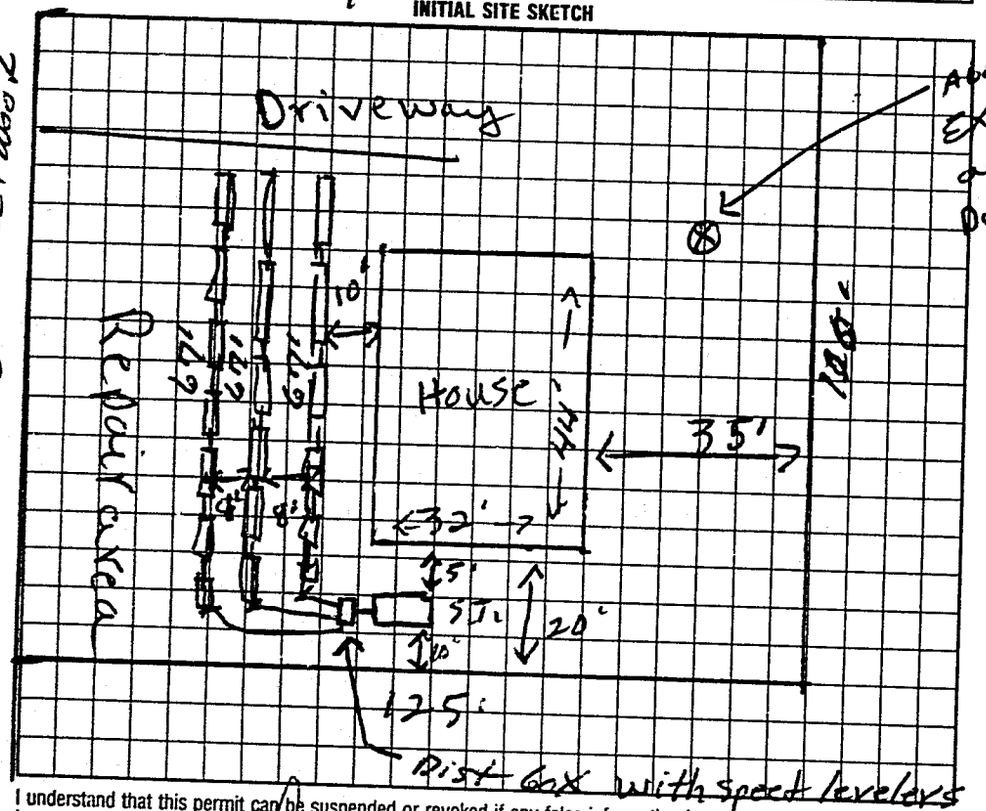

AS BUILT SKETCH

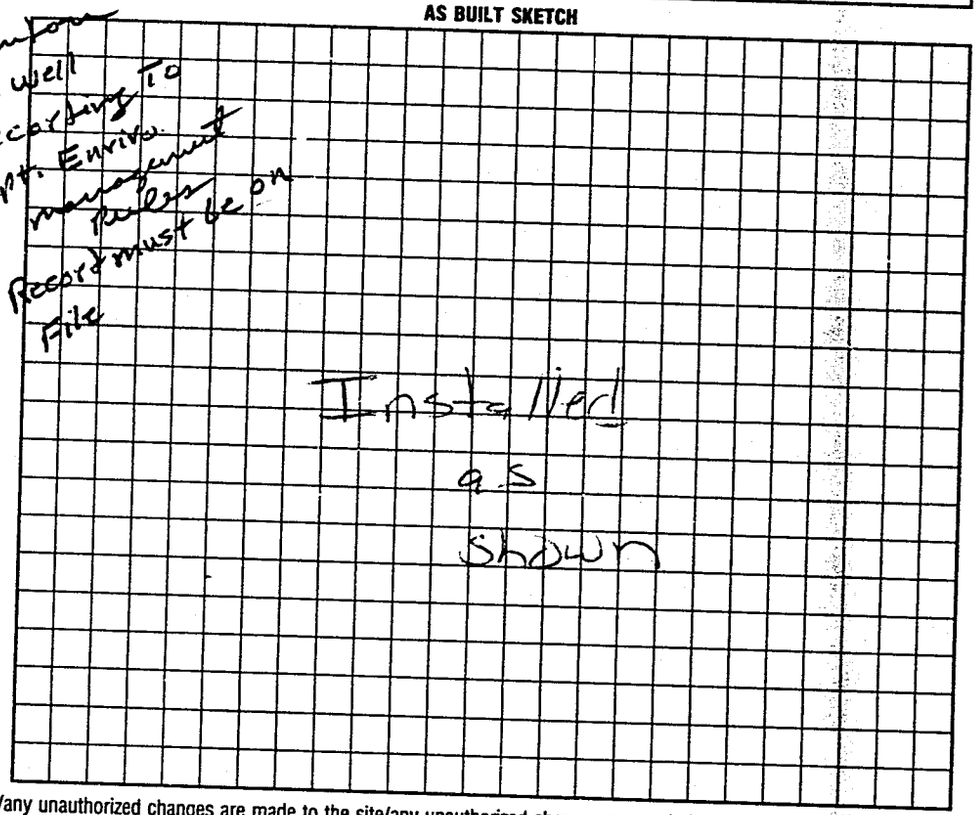

I understand that this permit can be suspended or revoked if any false information is supplied toward securing the permit/any unauthorized changes are made to the site/any unauthorized changes are made in the installation of the system. Improvement Permit is valid for 60 months from date of issuance.

Signed: Ken Yoon

Improvement Permit by: R.C. Moore date 6-2-97

Authorization Existing System Inspection by: R.C. Moore date 6-2-97

to cover

Installed by: A-1 Backhoe

Certificate of Completion by: date

Operation Permit by: 9 Day C.O.P. RS date 3-23-98

HEALTH DEPT. COPY: WHITE INSPECTION COPY (FINAL): GREEN OWNER COPY (FINAL): YELLOW INSPECTION COPY (INITIAL): PINK OWNER COPY (INITIAL): GOLD

Authorization to Cover Expires 60 mos from issue