IREDELL COUNTY HEALTH DEPARTMENT

STATESVILLE 704-878-5305 MOORESVILLE 704-664-5281

IMPROVEMENT PERMIT / CERTIFICATE OF COMPLETION / OPERATION PERMIT / EXISTING SYSTEM INSPECTION

PROPERTY DESCRIPTION NO. _____ DATE 6-2-97 TAX MAP NO. _____ Watershed: ☐ Yes ☐ No

OWNER OR CONTRACTOR Mary Ann Clark PHONE: Business _____ Home 873-8843

ADDRESS 249 Fleetwood Rd Statesville, N.C.

LOCATION 70 W TL Airport Rd TR Fleetwood Tswrk ent left

SUBDIVISION _____ BLOCK / SECTION _____ LOT _____ LOT AREA 100 X 125 SITE CLASS. _____ DESIGN FLOW _____ L.T.A.R. .3

Septic Tank: 1000 Gallons; STB _____ Date 5-7-97

Pump Tank: _____ Gallons; PT 1012 Date _____

Pump Make: _____ Model _____ Serial No. _____

Nitrification Field: No Fields 1 Square Feet 540 Linear Feet 180

No Lines 2 Trench Width 72" Max Trench Bottom Depth 36" Gravel Depth 18"

☐ New System ☑ Repair System Type: I, II, III, IV, V, VI

System Description: _____

Repair System Description: Conv. Gravity

Maintenance Agreement Required: ☐ Yes ☑ No

☑ House/Mod. Home No. Bedrooms 2

☐ Mobile Home No. Bathrooms _____

☐ Business No. Employees _____

☐ Other _____


☐ Slab ☑ Crawl Space ☐ Basement w/plumbing ☐ Basement wo/plumbing

Water Supply: ☑ Individual ☐ Community ☐ Public


Comments:

Comments:

INITIAL SITE SKETCH

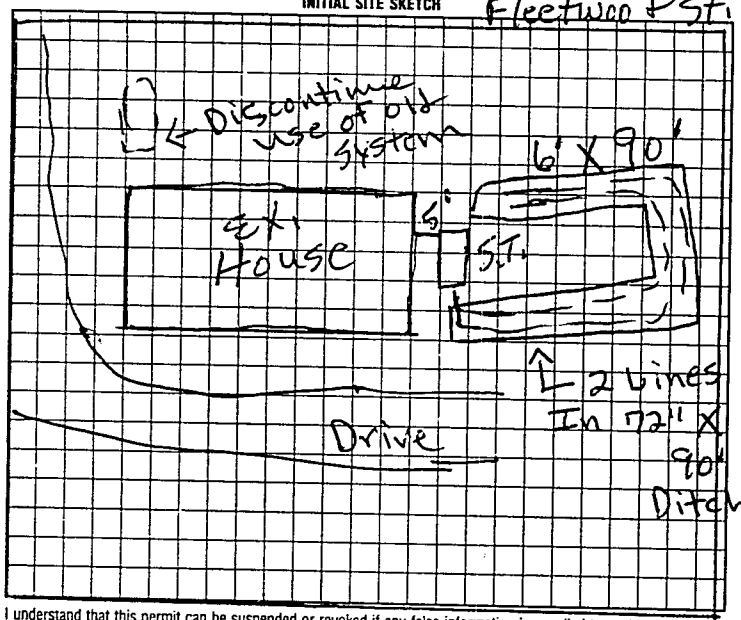

AS BUILT SKETCH

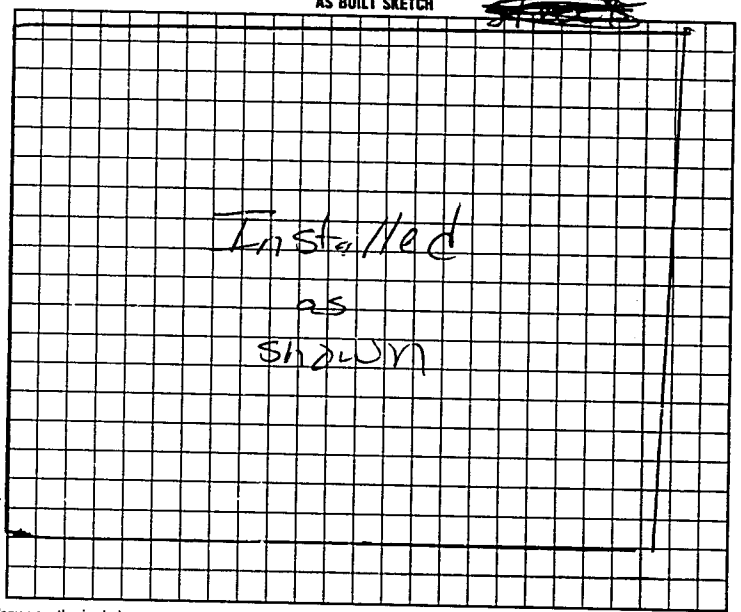

I understand that this permit can be suspended or revoked if any false information is supplied toward securing the permit/any unauthorized changes are made to the site/any unauthorized changes are made in the installation of the system. Improvement Permit is valid for 60 months from date of issuance.

Signed: X Mary Ann Clark

Improvement Permit by: L.C. Moore date 6-2-97

Authorization to Install (Existing System Inspection by) L.C. Moore date 6-2-97

to Court

Installed by: A-1 Backhoe

Certificate of Completion by: _____ date _____

Operation Permit by: _____ date 6-29-97

HEALTH DEPT COPY: WHITE INSPECTION COPY (FINAL): GREEN OWNER COPY (FINAL): YELLOW INSPECTION COPY (INITIAL): PINK OWNER COPY (INITIAL): GOLD

Authorization to Court EXPIRES 60 mos from issue

LE1000