Kyle Oaks
128 Garrison Dr
Permit # 178239

Location of the proposed 18'x36' out-building addition does not appear to impact the existing on-site septic system.**NOTE:

Justin D Henderson REHS
Date: 4-18-13
ICHD-Environmental Health Division

IREDELL COUNTY HEALTH DEPARTMENT

STATESVILLE 704-878-5305 MOORESVILLE 704-664-5281

IMPROVEMENT PERMIT / CERTIFICATE OF COMPLETION / OPERATION PERMIT / EXISTING SYSTEM INSPECTION

PROPERTY DESCRIPTION NO. 66735 DATE 5-3-97 TAX MAP NO. 4723 11 9330 Watershed: ☐ Yes ☐ No
OWNER OR CONTRACTOR Kyle Oaks PHONE: Business Home 704-872-6867
ADDRESS 532 Stoney Brook Rd
LOCATION I-40 West / TL oil mtn Rd TL Spring meadows TR Garrison on Rt.
SUBDIVISION Spring Meadows BLOCK / SECTION LOT 12 LOT AREA 9.98 acres SITE CLASS. PS DESIGN FLOW 450 L.T.A.R. 1.23

Septic Tank: 1000 Gallons: STB 4212 Date 3-3-99
Pump Tank: Gallons; PT Date
Pump Make: Model Serial No.
Nitrification Field: No Fields 1 Square Feet 1440 Linear Feet 480
No Lines 4 Trench Width 36" Max Trench Bottom Depth 76" Gravel Depth 12"

☐ New System ☐ Repair System Type: ☐ I, II, III, IV, V, VI
System Description: Conv. Gravity
Repair System Description: " "
Maintenance Agreement Required: ☐ Yes ☐ No
☐ Slab ☐ Crawl Space ☐ Basement w/plumbing ☐ Basement wo/plumbing

☐ House/Mod. Home No. Bedrooms 4
☐ Mobile Home No. Bathrooms 3
☐ Business No. Employees
☐ Other


Water Supply: ☐ Individual ☐ Community ☐ Public

Comments: 755'


Comments: Tank Turned 90° ~ ft from House

Slight rise in lines

INITIAL SITE SKETCH

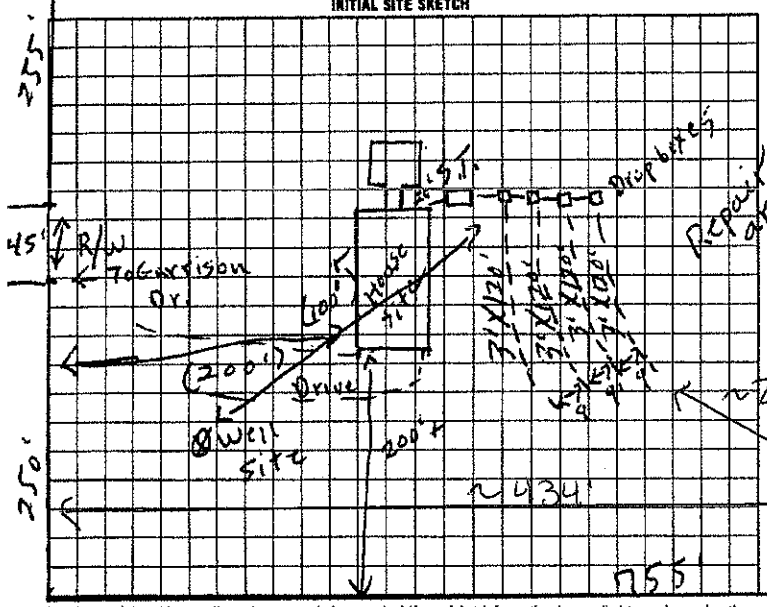

AS BUILT SKETCH

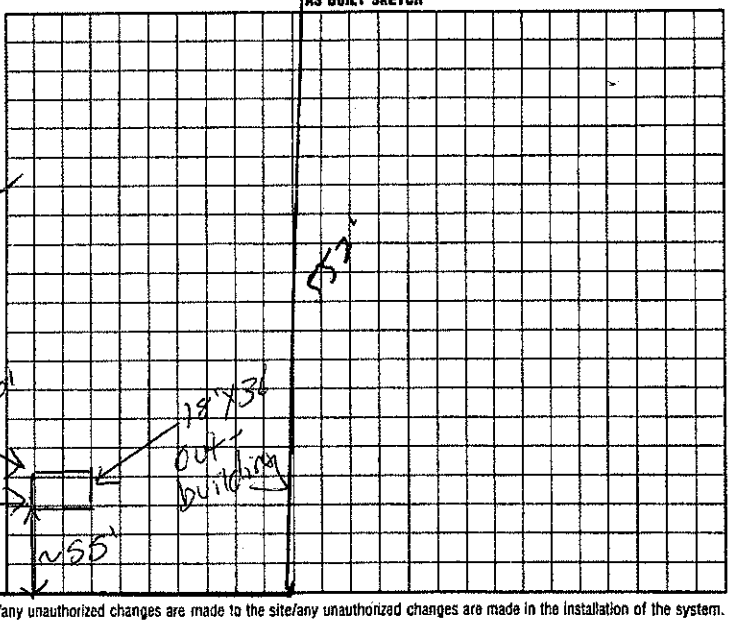

I understand that this permit can be suspended or revoked if any false information is supplied toward securing the permit/any unauthorized changes are made to the site/any unauthorized changes are made in the installation of the system. Improvement Permit is valid for 60 months from date of issuance.

Signed: X Kyle L. Oakes

Improvement Permit by: L.C. Moore date 6-3-97
Authorization to Construct
Existing System Inspection by: L.C. Moore date 6-3-97

Installed by: Tommy Fryer
Certificate of Completion by: Magic Cert PS date 4-26-99
Operation Permit by: date

HEALTH DEPT. COPY: WHITE INSPECTION COPY (FINAL): GREEN OWNER COPY (FINAL): YELLOW INSPECTION COPY (INITIAL): PINK OWNER COPY (INITIAL): GOLD

Authorization to Construct Expires 60 mos from issue