IREDELL COUNTY HEALTH DEPARTMENT

STATESVILLE 704-878-5305 MOORESVILLE 704-664-5281 52480

IMPROVEMENT PERMIT / CERTIFICATE OF COMPLETION / OPERATION PERMIT / EXISTING SYSTEM INSPECTION

PROPERTY DESCRIPTION NO. 18740 DATE 8-12-94 TAX MAP NO. 8K-9-A-21 Watershed: ☐ Yes ☑ No

OWNER OR CONTRACTOR Heritage Home Bldrs. PHONE: Business 466-2108 Home

ADDRESS 2192 Rowe - Scrum Lane Newton, N.C. 28658

LOCATION I40W TL Old Mtn. Rd TL Ridge Rd lot on corner of Ridge Rd and Garrison Dr.

SUBDIVISION Spring Meadows BLOCK / SECTION NA LOT 21 LOT AREA .94 acres SITE CLASS P.S DESIGN FLOW 360 L.T.A.R. -3 gpd/ft2

Septic Tank: 1000 Gallons; STB 784 Date 12/21/94
Pump Tank: — Gallons; PT — Date —
Pump Make: — Model — Serial No. —
Nitrification Field: No Fields 1 Square Feet 1200 Linear Feet 400'
No Lines 5 Trench Width 36" Max Trench Bottom Depth 24" Gravel Depth 12"

☑ New System ☐ Repair System Type: I, II, III, IV, V, VI
System Description: conventional, gravity fed
Repair System Description: "
Maintenance Agreement Required: ☐ Yes ☑ No


☑ House/Mod. Home No. Bedrooms 3
☐ Mobile Home No. Bathrooms 2.5
☐ Business No. Employees —
☐ Other —
☐ Slab ☑ Crawl Space ☐ Basement w/plumbing ☐ Basement w/o plumbing

Water Supply: ☑ Individual ☐ Community ☐ Public

Comments: INSTALL SYSTEM SHALLOW (no deeper than 24" to bottom of trench) Keep lines and trenches on contour. Keep system 5' from foundation of home, 10' from all property lines, 35' from interceptor drain on lot #20, and 50' min from any wells. 100% Repair Below system and in front of home.

Comments:

INITIAL SITE SKETCH

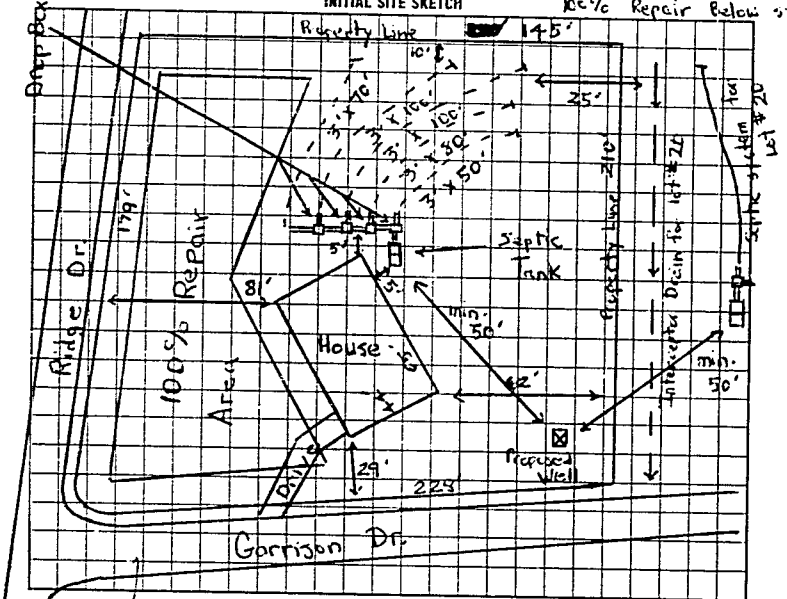

AS BUILT SKETCH

conventional, gravity fed.

SYSTEM INSPECTED ACCORDING TO INITIAL SITE SKETCH

I understand that this permit can be suspended or revoked if any false information is supplied toward securing the permit/any unauthorized changes are made to the site/any unauthorized changes are made in the installation of the system. Improvement Permit is valid for 60 months from date of issuance.

Signed: [signature]

Improvement Permit by: Michael D. Dennis / Steve Hedrick date 8-12-94

Existing System Inspection by — date —

Installed by: KENNEDY GRADING

Certificate of Completion by: STEVE HEDRICK date 3/13/95

Operation Permit by — date —

HEALTH DEPT. COPY: WHITE INSPECTION COPY (FINAL): GREEN OWNER COPY (FINAL): YELLOW INSPECTION COPY (INITIAL): PINK OWNER COPY (INITIAL): GOLD

219000