CI

IREDELL COUNTY HEALTH DEPARTMENT

STATESVILLE 704-878-5305 MOORESVILLE 704-664-5281

IMPROVEMENT PERMIT / AUTHORIZATION TO CONSTRUCT / OPERATION PERMIT / EXISTING SYSTEM INSPECTION

PERMIT# 142190 PIN# 4723-12-3476 DATE 5-17-07

OWNER OR APPLICANT DISTINCTIVE BUILDERS PHONE: Business 704-902-5352 Home

ADDRESS 116 ANGUS TRAIL, STATESVILLE, NC 28677

LOCATION OLD MOUNTAIN ROAD TO SPRING MEADOWS LANE, LOT #52 ON LEFT

SUBDIVISION SPRING MEADOWS BLOCK / SECTION LOT 52 LOT AREA LIMITED SITE CLASS PS DESIGN FLOW 360 L.T.A.R. 0.25 GPD/FT²

Septic Tank: 1000 Gallons; STB 794 Date 7-2007

Pump Tank: Gallons; PT Date

Pump Make: Model EQ. TO Serial No.

Nitrification Field: No Fields 1 Square Feet 1440 Linear Feet 360

No Lines THREE Trench Width 36" Max Trench Bottom Depth 25" Gravel Depth N/A ☐ Gravity ☐ Pressure

☑ New System ☐ Repair ☐ Expansion System Type: I II III IV V VI

System Description: 25% REDUCTION, GRAVITY

Repair System Description: 25% REDUCTION, LOW PRESSURE

Maintenance Agreement Required: ☐ Yes ☑ No

☑ House/Mod. Home ☐ Mobile Home ☐ Business ☐ Other

No. Bedrooms 3 No. Persons No. Employees

Water Supply: ☑ Individual ☐ Public ☐ Community WELL

☐ Slab ☑ Crawl Space ☐ Basement w/plumbing ☐ Basement wo/plumbing

Comments:/Conditions:

Comments:/Conditions: POLYLOK F. Hdr & RISERS
Installed AS Drawn with speed levelers

INITIAL SITE SKETCH

SEE ATTACHED "FAST TRACK" PLAN PREPARED BY ROWLANDS SOIL & ENVIRONMENTAL SERVICES PROJECT #: 01-1382

AS BUILT SKETCH

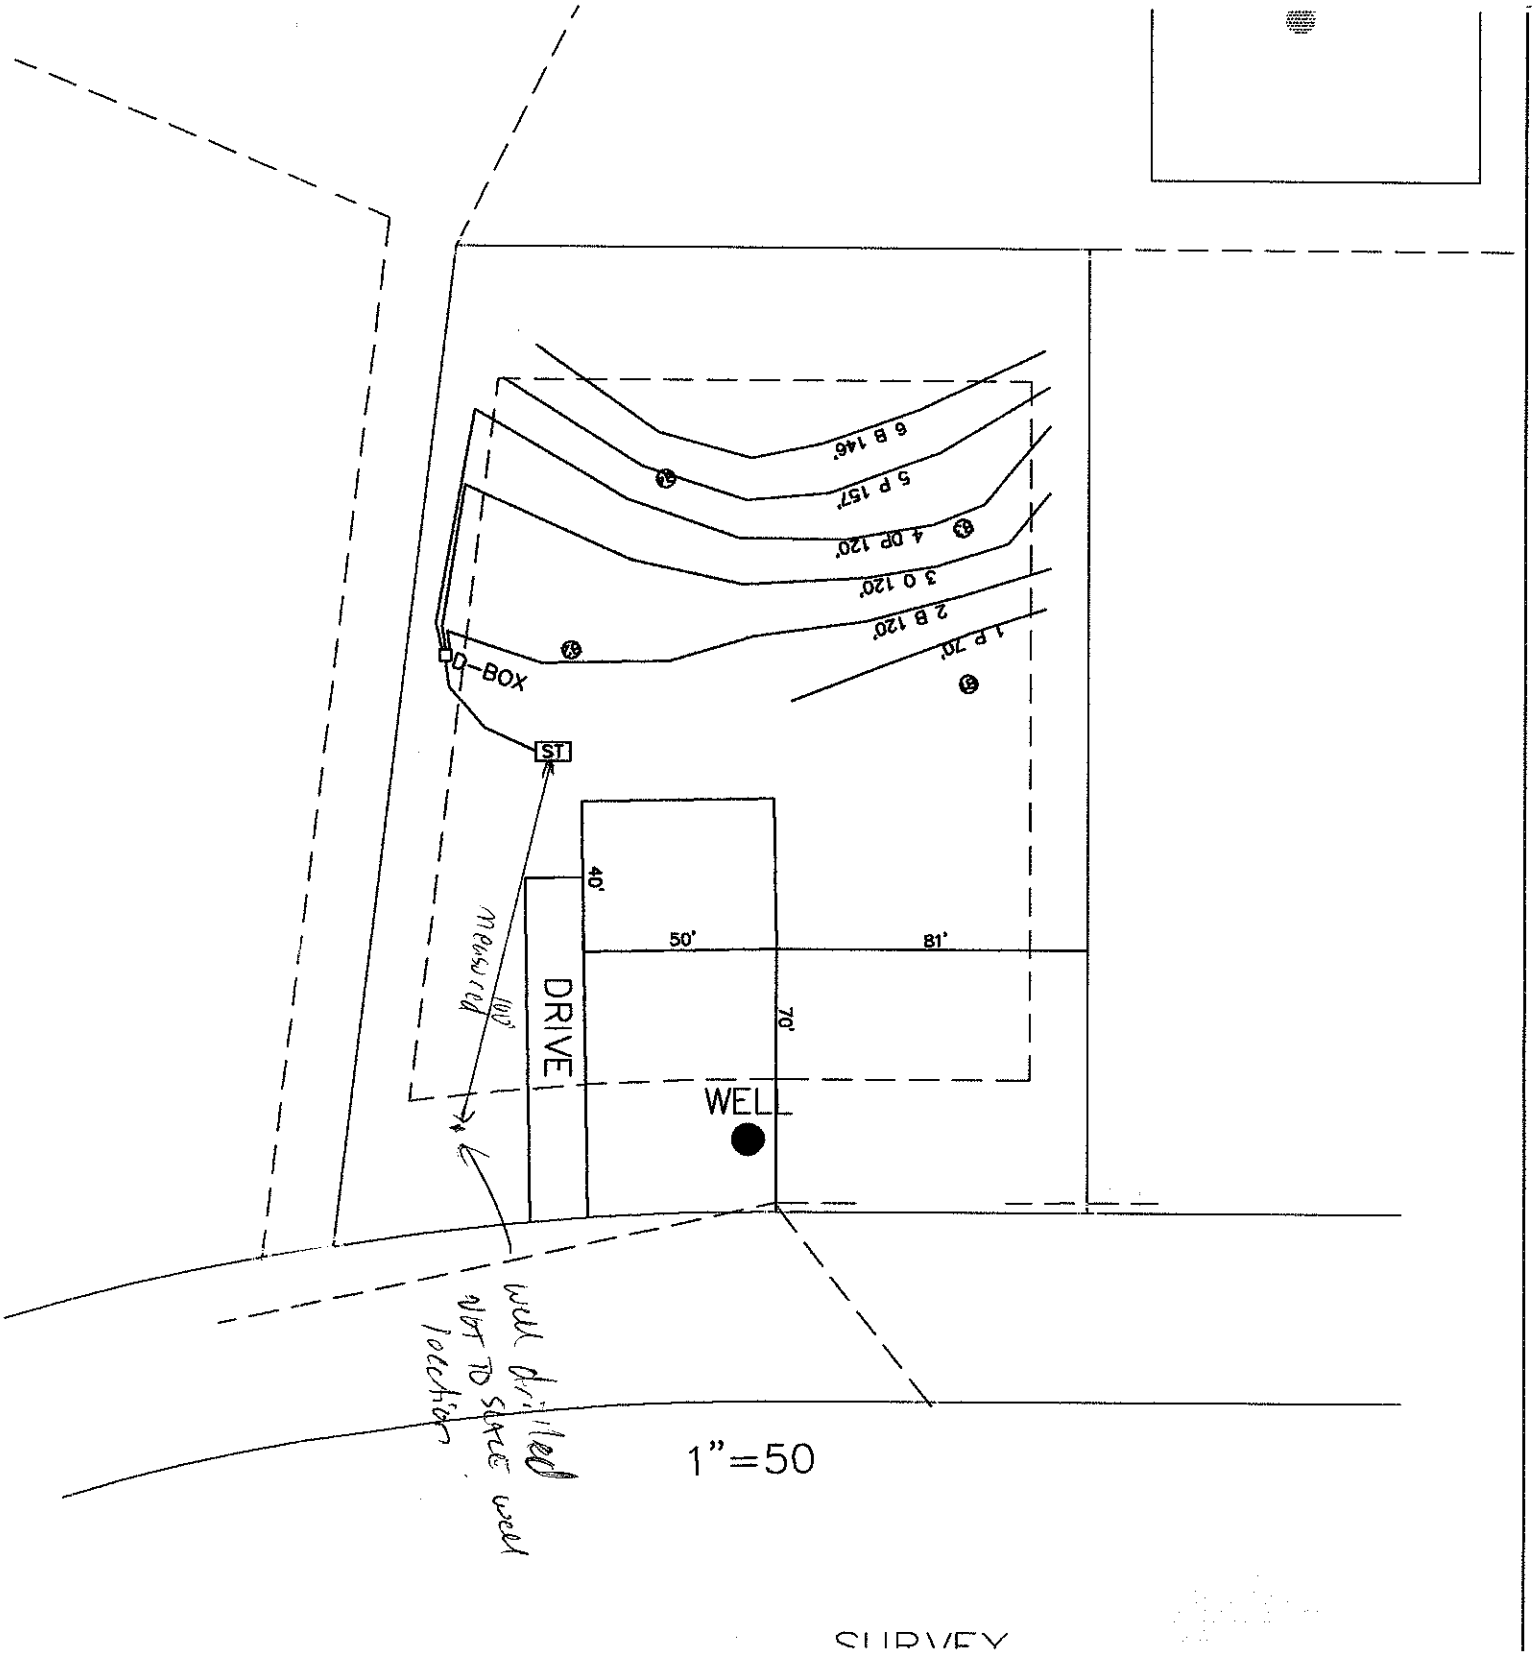
Permit can be suspended or revoked if any false information is supplied toward securing the permit/any unauthorized changes are made to the site/any unauthorized changes are made in the installation of the system. Improvement Permit with plat valid without expiration ☐ Improvement Permit with site plan valid for sixty months ☑ Authorization to Construct is valid for a period equal to that of Improvement Permit – not to exceed sixty months.

Signed: date 5-18-07 Installed by: Curt Bumgarner

Improvement Permit by: STEVE HEDRICK date 5-17-07 Operation Permit by: date 10-10-07

Authorization to Construct by: STEVE HEDRICK date 5-21-07 Existing System Inspection by: date

HEALTH DEPT. COPY: WHITE OWNER COPY (FINAL): YELLOW OWNER COPY (INITIAL): PINK


6 B 146'
5 P 157'
4 OP 120'
3 O 120'
2 B 120'
1 P 70'
O-BOX
ST
40'
50'
81'
70'
DRIVE
WELL
measured 100'
well drilled NOT TO SCALE well location
1"=50

SURVEY