IREDELL COUNTY HEALTH DEPARTMENT

Statesville Office (704) 878-5305 Mooresville Office (704) 660-3625 PERMIT # 202923

IMPROVEMENT PERMIT / AUTHORIZATION TO CONSTRUCT / OPERATION PERMIT / EXISTING SYSTEM

PIN # 4723124272

APPLICANT: Jeanie Kincaid APPLICANT ADDRESS: 172 Spring Meadows Ln Statesville NC 28677

SITE ADDRESS: 172 Spring Meadows Ln Statesville NC 28677 PHONE: 704-402-6885 ALT. PHONE: N/A

SITE DIRECTIONS: 40 W to Old Mtn Rd T/L then T/L on Spring Meadows Ln

SUBDIVISION: Spring Meadows SECTION: N/A LOT # 22 LOT AREA: DESIGN FLOW: EX L.T.A.R.: EX

Septic Tank	EX	(gal)	STB	EX	Date	EX	☐ New System ☐ Repair ☐ Expansion	System Type: I (II) III IV V VI	
Pump Tank	N/A	(gal)	PT	N/A	Date	N/A	System Description:	EXISTING	
Pump Make	N/A	Model		N/A	Serial #	N/A	Repair System Description:		
# Nitrification Fields	1	# Lines		EX	Linear Ft:	EX	Maintenance Agreement Required:	☐ YES ☒ NO	
Trench Width	EX	Max. Trench Bottom Depth		EX	Gravel Depth	EX	☒ GRAVITY ☐ PRESSURE		


☒ Residence No. Bedrooms EX
☐ Business No. Persons EX
☐ Other No. Employees
☐ Slab ☒ Crawl Space
☐ Basement w/plumbing ☐ Basement w/o plumbing

Water Supply: ☒ Private ☐ Public ☐ Community

Comments / Conditions: All pools must be 5ft from any part of STS

INITIAL SITE SKETCH

AS BUILT SKETCH

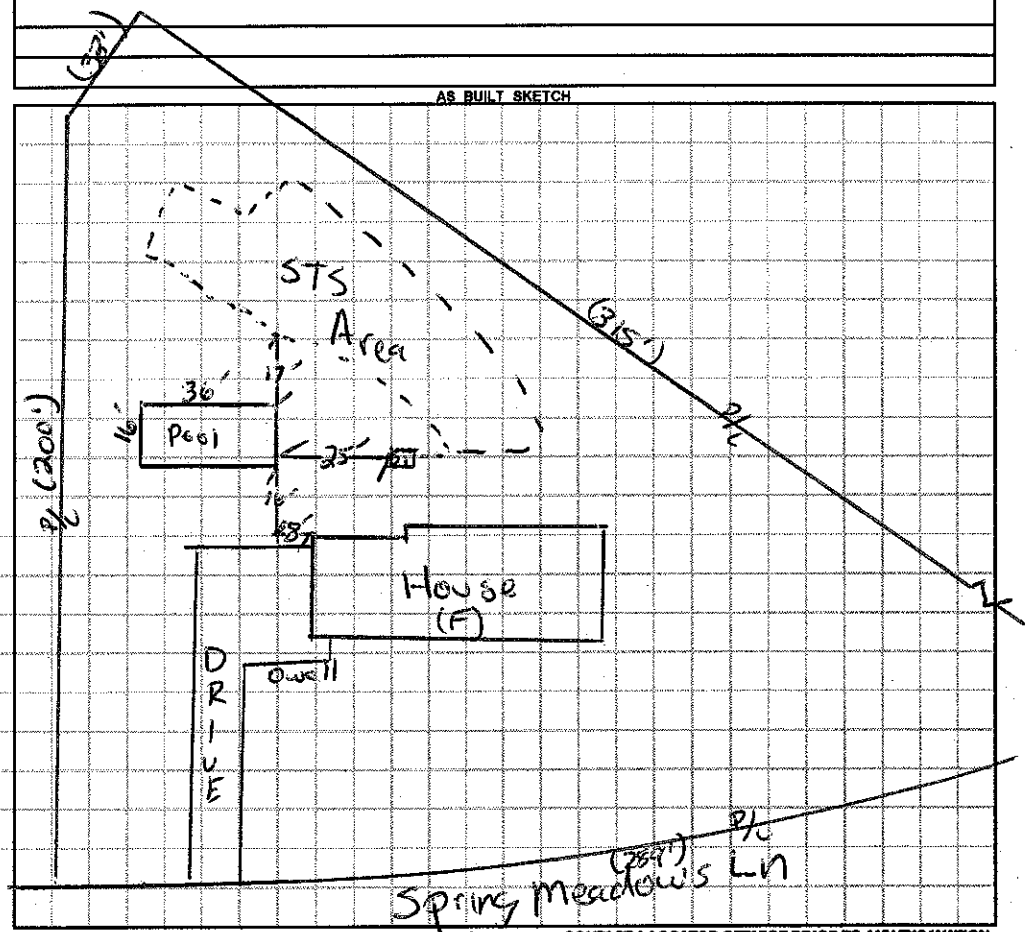

Permit can be suspended or revoked if any false information is supplied toward securing the permit / any unauthorized changes are made to the site / any unauthorized changes are made in the installation of the system. **CONTACT A LOCATOR SERVICE PRIOR TO ANY EXCAVATION**

☐ **IMPROVEMENT PERMIT** *with plat valid without expiration.* ☐ **IMPROVEMENT PERMIT** *with site plan valid for 60 mos.* ☐ **AUTHORIZATION TO CONSTRUCT** *valid for period equal to IMPROVEMENT PERMIT--not to exceed 60 mo.*

Owner / Applicant Signature: Jeanie Kincaid Date: 5-12-14 Installed by:

IMPROVEMENT PERMIT by: Date: OPERATION PERMIT by: Date:

AUTHORIZATION TO CONSTRUCT by: Date: Existing System Inspected by: Date: 04/30/14

Health Dept. Copy - WHITE Applicant (Final Approval) - YELLOW Applicant (Conditional Approval) - PINK