The proposed Detached Garage addition does not appear to impact the existing septic system.
**NOTE: Structure must be 25'± from well
Jim Riggs R.S.
Date: 16 Dec. 08
ICHD-Environmental Health Division

IREDELL COUNTY HEALTH DEPARTMENT

STATESVILLE 704-878-5305 MOORESVILLE 704-664-5281

53095

IMPROVEMENT PERMIT / CERTIFICATE OF COMPLETION / OPERATION PERMIT / EXISTING SYSTEM INSPECTION

PROPERTY DESCRIPTION NO 1931 DATE 9-13-94 TAX MAP NO 8K-9-A-24-25 Watershed: Yes No

OWNER OR COMMERCIAL Michael L. Ingram Builder PHONE Business Home 873-6922

ADDRESS 1002 Harvest Dr. Statesville, N.C. 28677

LOCATION I-40W TL on Mt. Ru. TL Spring Meadow Lane 4th & 5th lots to R. first Garrison Dr.

SUBDIVISION Spring Meadows UNIT SECTION 24-25 LOT SIZE 200' X 246' SITE CLASS P.S. DESIGN FLOW 360 T.P.A.: 3 yrs 1152

Septic Tank 1000 Gallons Set 11-10-94 Pump Tank — Gallons — Date —

Pump Make — Model — Pump No —

Distribution Box No Outlets 1 Square Feet in Trench — Linear Feet 400'

No Lines 5 Trench Width 24" Trench Bottom Depth 24" 36" Gravel Depth 12"

Water System: None System Type: Other (Specify)

System Description: Conventional / gravity fed

Pumped System Description

Maintenance Agreement Required Yes No

House/Mod Home No Bedrooms 3 2

Mobile Home No Bathrooms

Business No Employees


Other

Slab Crawl Space Basement w/plumbing Basement w/o plumbing


Water Supply: Municipal Community Public

Comments: SYSTEM SHALL be deep than 36" to trench bottom. Keep top soil from system area. Grade surface drainage away from system to allow proper drainage. Use to replace below system conventional.

INITIAL SITE SKETCH

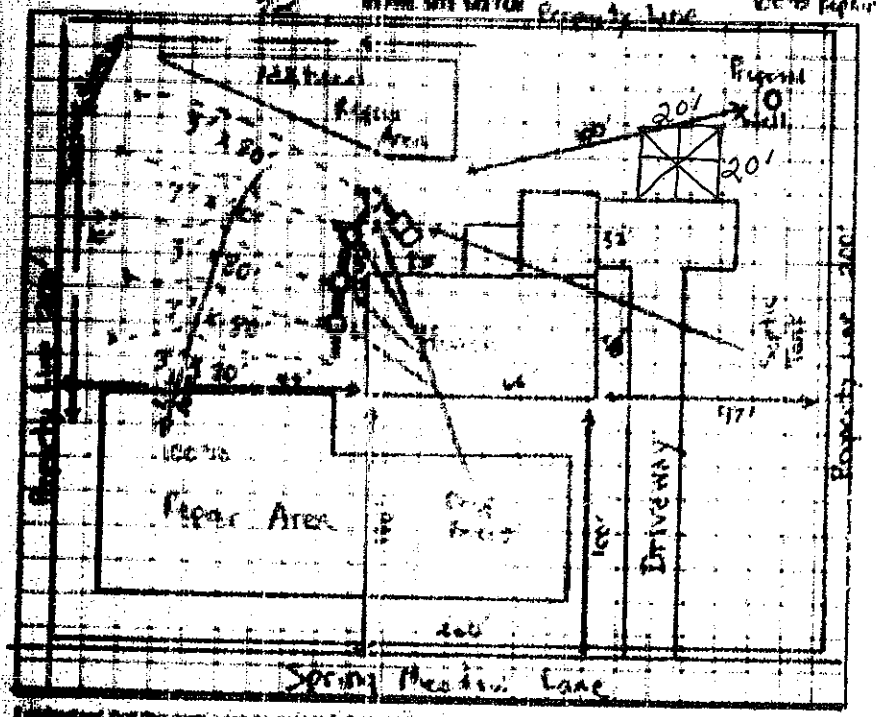

AS BUILT SKETCH

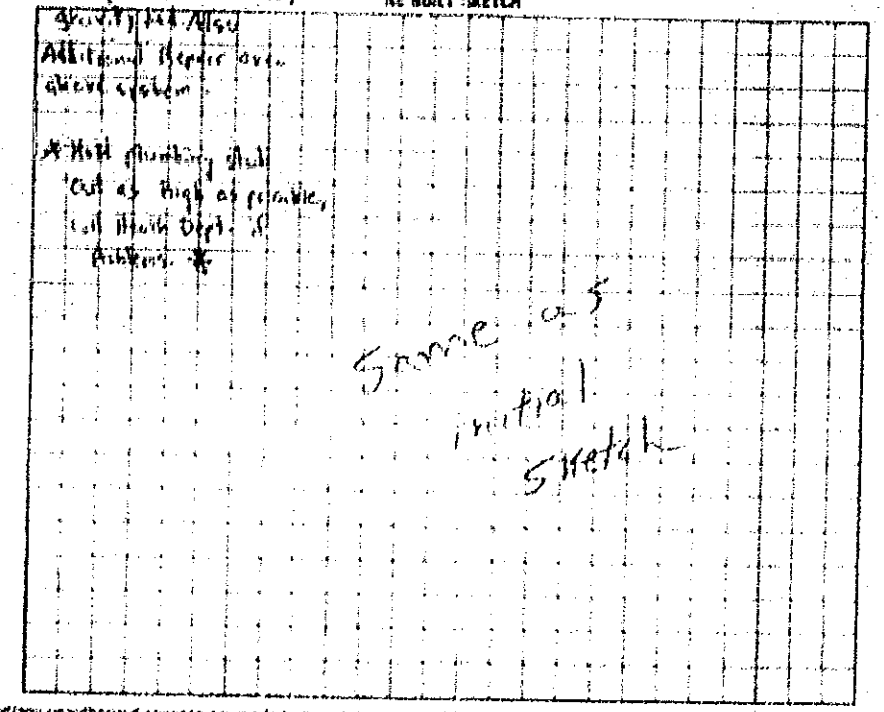

I understand that this permit can be suspended or revoked if any false information is supplied toward securing the permit any unauthorized changes are made to the design unauthorized changes are made in the installation of the system

Improvement Permit by Michael L. Ingram date 9-13-94

Existing System Inspection by date

Installed by W.C.S. Fytton

Certificate of Completion by P. C. Moore date 12-28-9

Operation Permit by date

JAN. 7, 1989 20:43