IREDELL COUNTY HEALTH DEPARTMENT

STATESVILLE 704-878-5305 MOORESVILLE 704-664-5281

IMPROVEMENT PERMIT / AUTHORIZATION TO CONSTRUCT / OPERATION PERMIT / EXISTING SYSTEM INSPECTION

PERMIT# 74588 PIN# 4723 12 9821

OWNER OR CONTRACTOR Randall myers PHONE: Business Home 878 0616 DATE 7-7-98

ADDRESS 2534 Hickory Hwy Statesville

LOCATION OMR Turn Right Dr on left.

SUBDIVISION SP meadows BLOCK / SECTION LOT 14 LOT AREA 130'X200' SITE CLASS P3 DESIGN FLOW 360 L.T.A.R. .28

Septic Tank: 1000 Gallons; STB 1017 Date 8-16-95

Pump Tank: Gallons; PT Date

Pump Make: Model Serial No.

Nitrification Field: No Fields 1 Square Feet 908 Linear Feet 326

No Lines 6 Trench Width 36" Max Trench Bottom Depth 36" Gravel Depth N/A

☑ New System ☐ Repair System Type: I, II, III, IV, V, VI

System Description: Gravity Chambers

Repair System Description: LPP / HDS orange approved 5-20-98 RC

Maintenance Agreement Required: ☐ Yes ☑ No ☐ Other

☑ House/Mod. Home ☐ Mobile Home ☐ Business No. Bedrooms 3 No. Bathrooms 2 No. Employees


☐ Slab ☑ Crawl Space ☐ Basement w/plumbing ☐ Basement wo/plumbing

Water Supply: ☑ Individual ☐ Public ☐ Community


Comments:/Conditions:

Comments:/Conditions:

INITIAL SITE SKETCH

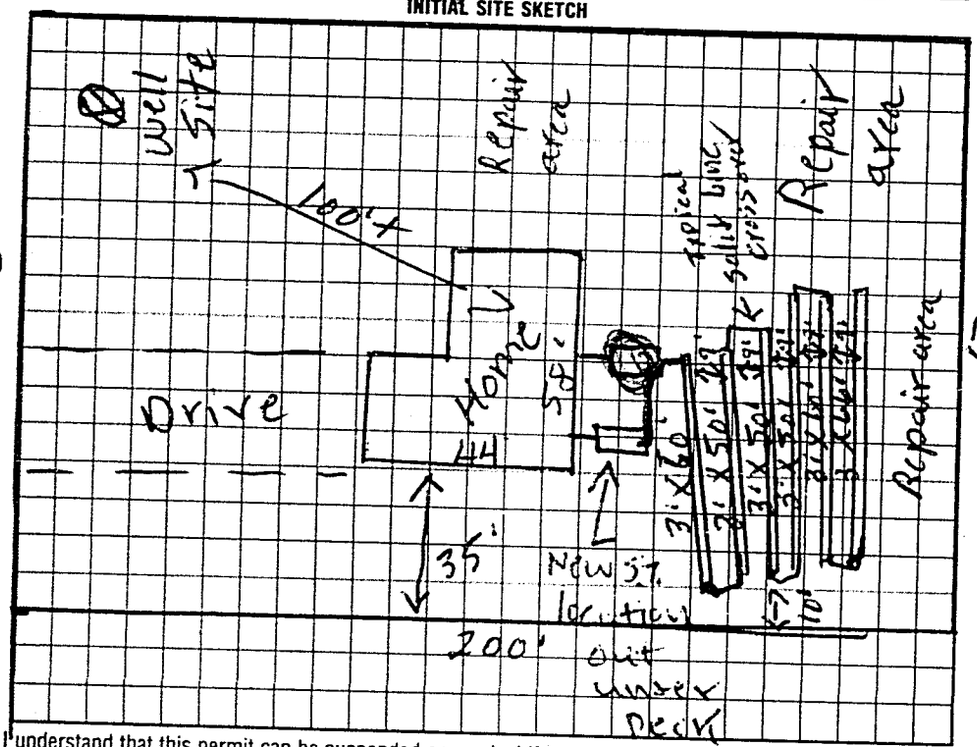

AS BUILT SKETCH

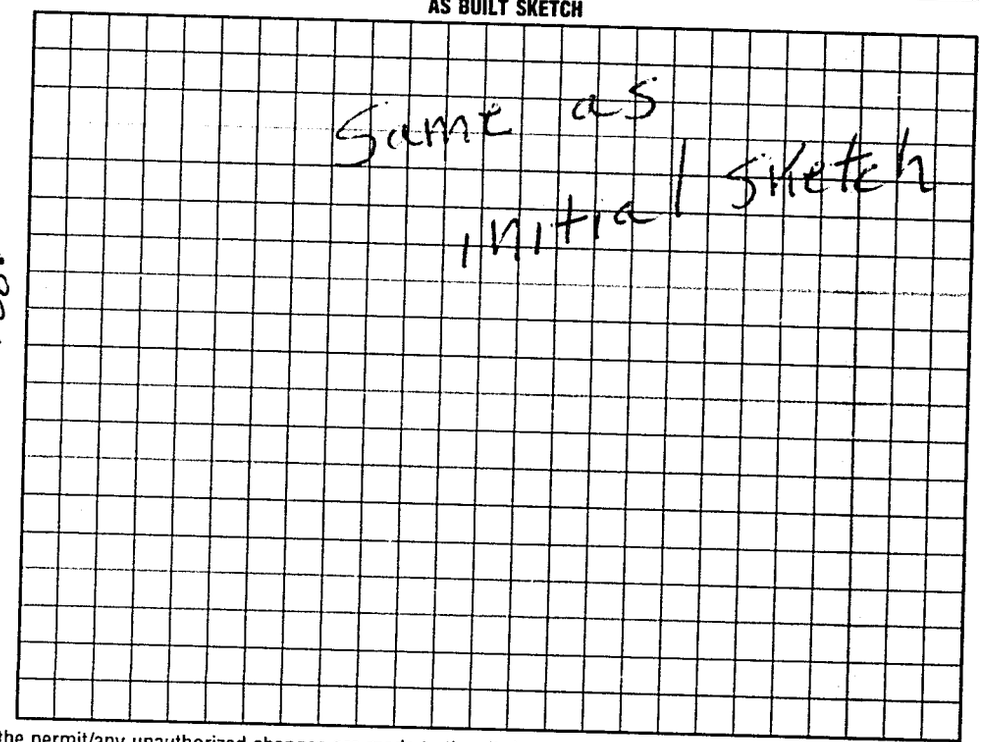

I understand that this permit can be suspended or revoked if any false information is supplied toward securing the permit/any unauthorized changes are made to the site/any unauthorized changes are made in the installation of the system. Improvement Permit with plat valid without expiration. Improvement Permit with site plan valid for sixty months. Authorization to Construct is valid for a period equal to that of Improvement Permit – not to exceed sixty months.

Signed: Randall K Myers date 7-13-98

Improvement Permit by: R.C. moore date 7-7-98

Authorization to Construct by: R.C. moore date 7-7-98

Installed by: Byot Adams Grading (Alex Co.)

Operation Permit by: R.C. Moore date 10-22-98

Existing System Inspection by: date

HEALTH DEPT. COPY WHITE INSPECTION COPY (FINAL) GREEN OWNER COPY (FINAL) YELLOW INSPECTION COPY (INITIAL) PINK OWNER COPY (INITIAL) BLUE