This permit voids permit dated 4-2-98

IREDELL COUNTY HEALTH DEPARTMENT

STATESVILLE 704-878-5305 MOORESVILLE 704-664-5281

IMPROVEMENT PERMIT / AUTHORIZATION TO CONSTRUCT / OPERATION PERMIT / EXISTING SYSTEM INSPECTION

PERMIT# Repair PIN#

OWNER OR CONTRACTOR Lynn Hartzog DATE 4-23-98

ADDRESS 187 Spring Meadows Dr Statesville PHONE: Business Home

LOCATION I-40 TL Comb TL Spring Meadows House on left side off road

SUBDIVISION BLOCK / SECTION LOT LOT AREA SITE CLASS. DESIGN FLOW 480 L.T.A.R.

Septic Tank: 1000 Exist Gallons; STB Date

Pump Tank: Gallons; PT Date

Pump Make: Model Serial No. 300

Nitrification Field: No Fields 1 Square Feet Linear Feet 250

No Lines 2 Trench Width 36 Max Trench Bottom Depth 36 Gravel Depth 12

☐ New System ☒ Repair System Type: I, II, III, IV, V, VI

System Description:

Repair System Description: Gravity Conventional

Maintenance Agreement Required: ☐ Yes ☐ No

☒ House/Mod. Home ☐ Mobile Home ☐ Business ☐ Other

No. Bedrooms 4 No. Bathrooms 3 No. Employees


☐ Slab ☐ Crawl Space ☒ Basement w/plumbing ☐ Basement wo/plumbing

Water Supply: ☒ Individual ☐ Public ☐ Community


Comments:/Conditions: keep lines on contour 50 ft from well

Comments:/Conditions:

INITIAL SITE SKETCH

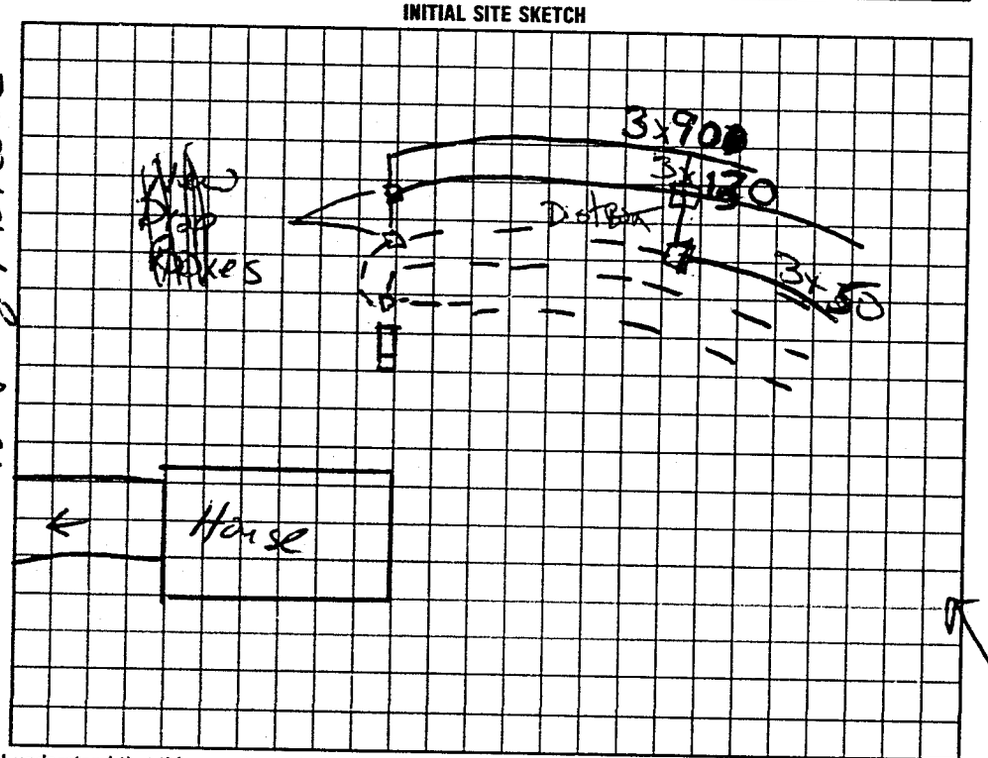

AS BUILT SKETCH

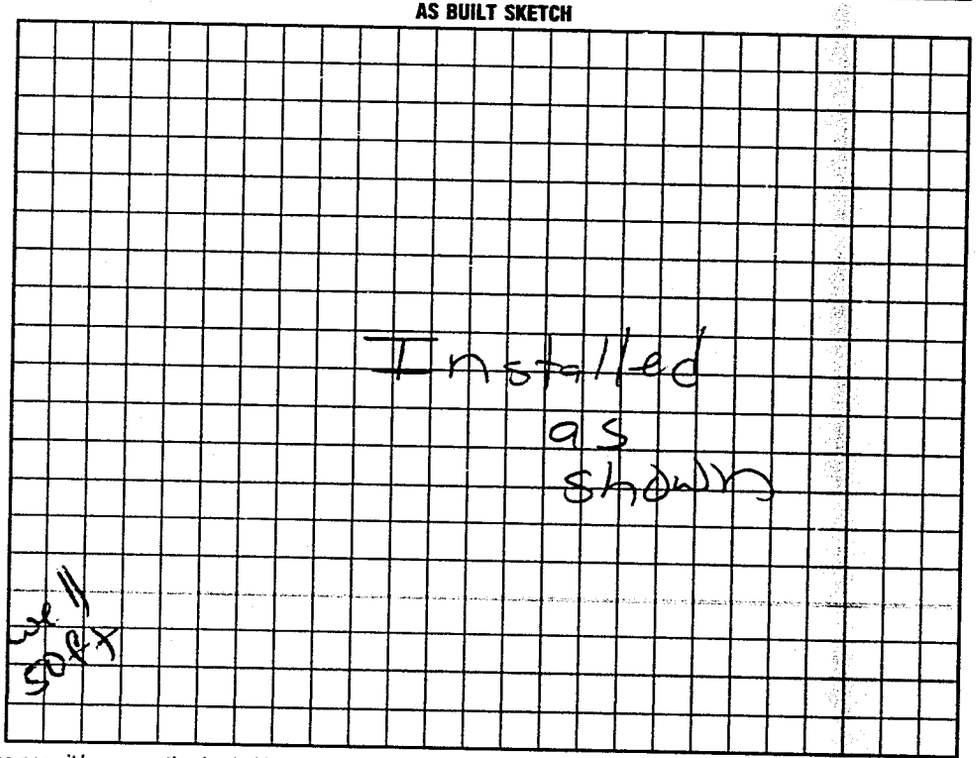

I understand that this permit can be suspended or revoked if any false information is supplied toward securing the permit/any unauthorized changes are made to the site/any unauthorized changes are made in the installation of the system. Improvement Permit with plat valid without expiration. Improvement Permit with site plan valid for sixty months. Authorization to Construct is valid for a period equal to that of Improvement Permit – not to exceed sixty months.

Signed: Lynn Hartzog date 4-26-98 Installed by: Wes Lytton

Improvement Permit by: Mark C. Outlaw date 4-23-98 Operation Permit by: Mark C. Outlaw date 6-26-98

Authorization to Construct by: Mark C. Outlaw date 4-23-98 Existing System Inspection by: date

HEALTH DEPT COPY: WHITE INSPECTION COPY (FINAL): GREEN OWNER COPY (FINAL): YELLOW INSPECTION COPY (INITIAL): PINK OWNER COPY (INITIAL): GOLD