IREDELL COUNTY HEALTH DEPARTMENT

STATESVILLE 704-878-5305 MOORESVILLE 704-664-5281

IMPROVEMENT PERMIT / AUTHORIZATION TO CONSTRUCT / OPERATION PERMIT / EXISTING SYSTEM INSPECTION

DATE 2-04-02

PERMIT# 104218 PIN# 4723-22-0691

OWNER OR CONTRACTOR DAVID R. MEEHAN INC PHONE: Business 704-902-0286 Home 704-528-6378

ADDRESS 105 GALAX DR., STATESVILLE, NC 28677

LOCATION I-40 W, TL OLD MTN. RD, TL SPRING MEADOWS LANE, LOT ON RIGHT BEFORE ANGUS DRIVE

SUBDIVISION SPRING MEADOWS BLOCK / SECTION ____ LOT 64 LOT AREA 0.76 ACRE SITE CLASS PS DESIGN FLOW 360 L.T.A.R. 0.25 GPD/FT²

Septic Tank: 1000 Gallons: STB 1012 Date 04/30/02

Pump Tank: ____ Gallons; PT ____ Date ____

Pump Make: ____ Model ____ Serial No ____

Nitrification Field: No Fields 1 Square Feet 1440 Linear Feet 480

No Lines FIVE Trench Width 36" Max Trench Bottom Depth 36" Gravel Depth 12"

☑ New System ☐ Repair System Type I II III IV V VI

System Description: CONVENTIONAL GRAVITY

Repair System Description: 50% REDUCTION, PUMP

Maintenance Agreement Required: ☐ Yes ☑ No

☐ Slab ☑ Crawl Space ☐ Basement w/plumbing ☐ Basement wo/plumbing

☑ House/Mod Home ☐ Mobile Home ☐ Business ☐ Other


No. Bedrooms 3 No. Bathrooms 2 No. Employees ____

Water Supply: ☑ Individual ☐ Public ☐ Community WELL

Comments/Conditions: INSTALL SUBSURFACE INTERCEPT DRAINAGE DITCH AT LOCATION SHOWN BEGINNING 48" DEEP - AROUND END, THEN OUT TO DAYLIGHT

Comments/Conditions: SEPTIC TANK INSTALLED USING SEPTIC MARKER + TUFF TIGHT FILTER

INITIAL SITE SKETCH SCALE: 1" = 40'

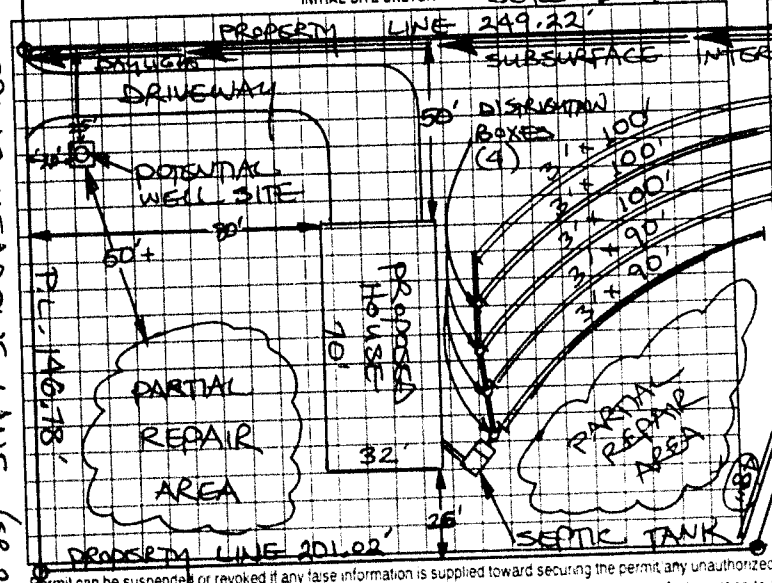

AS BUILT SKETCH

- SYSTEM INSTALLED AS SHOWN ON INITIAL SITE SKETCH

SPRING MEADOWS LANE (SR 2753)

Permit can be suspended or revoked if any false information is supplied toward securing the permit any unauthorized changes are made to the site any unauthorized changes are made in the installation of the system. Improvement Permit with plat valid without expiration. Improvement Permit with site plan valid for sixty months. Authorization to Construct is valid for a period equal to that of Improvement Permit – not to exceed sixty months.

Signed: David Meehan date 2-6-02 Installed by TOM FRYE GRADING + SEPTIC

Improvement Permit by: STEVE HEDRICK date 2-04-02 Operation Permit by: [signature] date 09/04/02

Authorization to Construct by: STEVE HEDRICK date 2-04-02 Existing System Inspection by: ____ date ____

HEALTH DEPT COPY WHITE OWNER COPY (FINAL) YELLOW OWNER COPY (INITIAL) PINK