Ricky upright (owner) 46948

IREDELL COUNTY HEALTH DEPARTMENT

STATESVILLE 704-878-5305 MOORESVILLE 704-664-5281

IMPROVEMENT PERMIT / CERTIFICATE OF COMPLETION / OPERATION PERMIT / EXISTING SYSTEM INSPECTION

PROPERTY DESCRIPTION NO. 16124 DATE 8-20-93 TAX MAP NO. 9K-9-A-43

OWNER OR (CONTRACTOR) Dennis Hutchens PHONE: Business _____ Home _____

ADDRESS _____

LOCATION I40W TL OW Mtn. Rd. TL Spring Meadows. TL Angus Rd. 2nd Lot Lot

SUBDIVISION Spring Meadows BLOCK / SECTION _____ LOT 43 LOT AREA _____ SITE CLASS. P.S. L.T.A.R. .35 gpd/ft²

Water Supply: ☑ Individual ☐ Community ☐ Public Well

Septic Tank: 1250 Gallons: STB 354 Date 7-1-92

Pump Tank: — Gallons: PT — Date —

Nitrification Field: No Fields 1 Square Feet 1035 Linear Feet 345'

No Lines 3 Trench Width 36" Trench Depth 18"-30" Gravel Depth 12"

☑ New System ☐ Repair System Type: I (II) III. IV. V. VI

System Description: Conventional, gravity

Repair System Description: "

Maintenance Agreement Required: ☐ Yes ☑ No

☑ House/Mod. Home ☐ Mobile Home ☐ Business ☐ Other _____

No. Bedrooms 3 No. Bathrooms 2 No. Employees —

☐ Slab ☑ Crawl Space ☐ Basement w/plumbing ☐ Basement wo/plumbing

Garbage Disposal: ☑ Yes ☐ No


Auto. Dishwasher: ☑ Yes ☐ No

Auto. Washing Machine: ☑ Yes ☐ No


Other _____

Comments 100% Repair Area toward Rd., Conventional, gravity fed

INITIAL SITE SKETCH

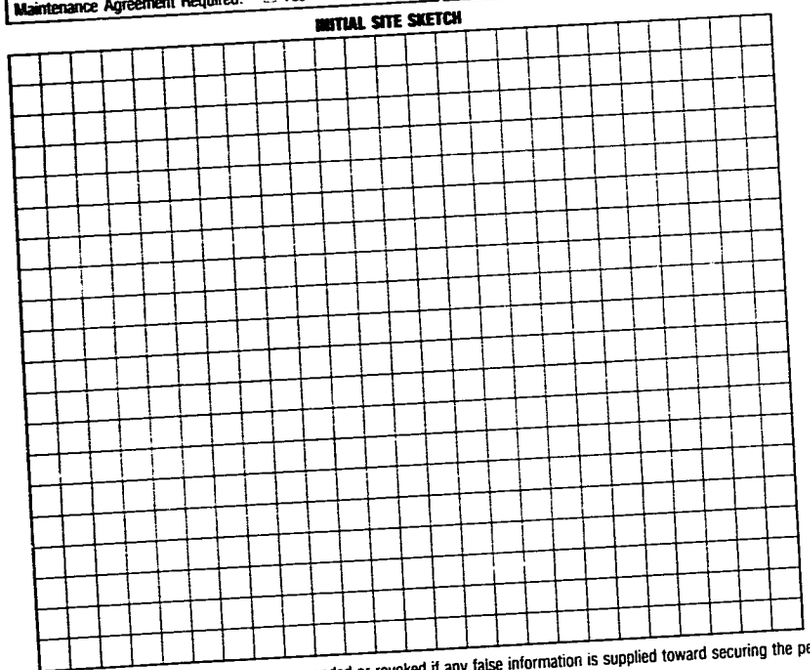

AS BUILT SKETCH

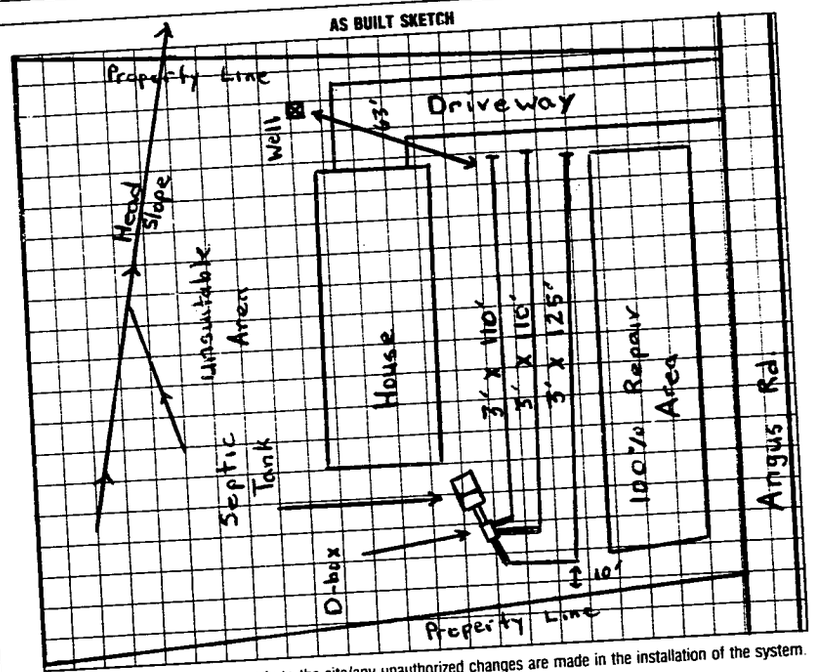

I understand that this permit can be suspended or revoked if any false information is supplied toward securing the permit/any unauthorized changes are made to the site/any unauthorized changes are made in the installation of the system. Improvement Permit is valid for 60 months from date of issuance.

Signed: _____

Improvement Permit by: Michael J. Dennis date 9-19-93

Existing System Inspection by: _____ date _____

Installed by: A-1 Backhoe

Certificate of Completion by: Michael J. Dennis date 8-20-93

Operation Permit by: _____ date _____

HEALTH DEPT. COPY: WHITE INSPECTION COPY (FINAL): GREEN OWNER COPY (FINAL): YELLOW INSPECTION COPY (INITIAL): PINK OWNER COPY (INITIAL): GOLD