# IREDELL COUNTY HEALTH DEPARTMENT

STATESVILLE 704-878-5305 MOORESVILLE 704-664-5281

## IMPROVEMENT PERMIT / AUTHORIZATION TO CONSTRUCT / OPERATION PERMIT / EXISTING SYSTEM INSPECTION

PERMIT# 8348 PIN# 4723234641 DATE Dec 3 99

OWNER OR CONTRACTOR TRACY DAGENHART PHONE: Business 881 0704 Ext 250 Home 876 1277

ADDRESS 117 Jenkins Rd Statesville

LOCATION Old Mtrd Stn (L) Spring Meadow (L) Angus Lt on Right in Culdesac

SUBDIVISION Spring Meadows BLOCK / SECTION LOT 36 LOT AREA 1.49 SITE CLASS 1S DESIGN FLOW 360 L.T.A.R. .3

Septic Tank: 1000 Gallons; STB 1012 Date 6-6-00
Pump Tank: Gallons; PT Date
Pump Make: Model Serial No.
Nitrification Field: No Fields 1 Square Feet 1200 Linear Feet 400
No Lines 4@100 Trench Width 36" Max Trench Bottom Depth 36" Gravel Depth 12"

☒ New System ☐ Repair System Type: I, (II), III, IV, V, VI
System Description: Conv Gravity
Repair System Description: Conv Gravity 25% Rsvd
Maintenance Agreement Required: ☐ Yes ☒ No

☒ House/Mod. Home ☐ Mobile Home ☐ Business ☐ Other
☐ Slab ☐ Crawl Space ☒ Basement w/plumbing ☐ Basement wo/plumbing


No. Bedrooms 3 No. Bathrooms 2 No. Employees

Water Supply: ☒ Individual ☐ Public ☐ Community
WELL


Comments/Conditions: INSTALL on CONTOUR
Remove Field TERRACE if Desired
LOCATE Septic TANK TO INSURE GRAVITY From BASEMENT
LOCATE well 100Ft (AT LEAST) From Septic System

Comments/Conditions: SEPTIC TANK WITH RISERS INSTALLED USING "POLY LOK" FILTER

INITIAL SITE SKETCH

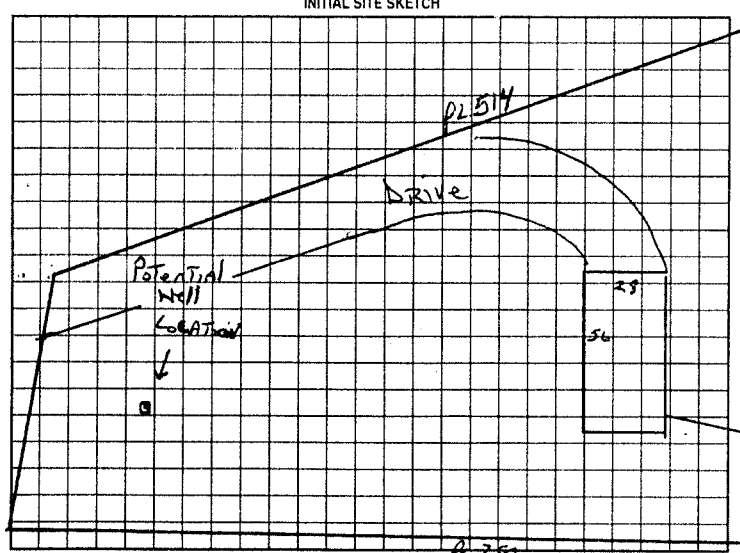


AS BUILT SKETCH

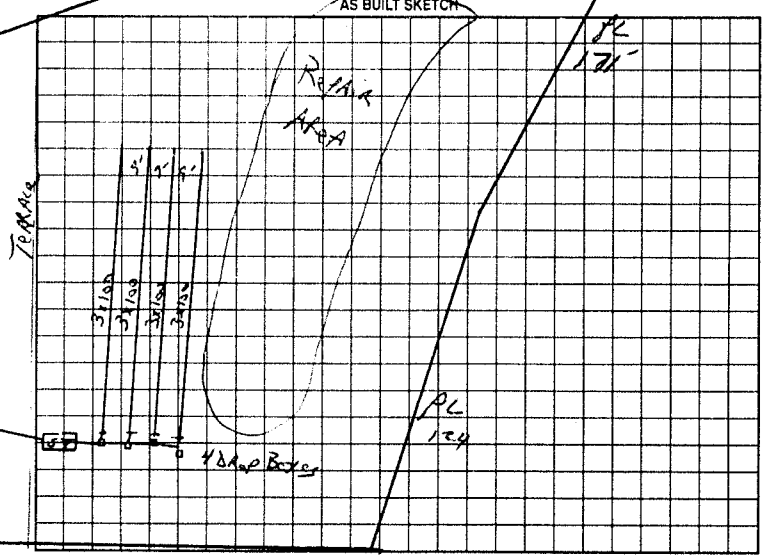


Permit can be suspended or revoked if any false information is supplied toward securing the permit/any unauthorized changes are made to the site/any unauthorized changes are made in the installation of the system. Improvement Permit with plat valid without expiration. Improvement Permit with site plan valid for sixty months. Authorization to Construct is valid for a period equal to that of Improvement Permit - not to exceed sixty months.

Signed: Mark S. Dagenhart date Dec 8 99 Installed by: DAVID YOUNTS

Improvement Permit by: JC Potter date Dec 3 99 Operation Permit by: STEVE HENDRICK date 8-23-00

Authorization to Construct by: JC Potter date Dec 3 99 Existing System Inspection by: date

HEALTH DEPT COPY WHITE OWNER COPY (FINAL) YELLOW OWNER COPY (INITIAL) PINK