IREDELL COUNTY HEALTH DEPARTMENT

STATESVILLE 704-878-5305 MOORESVILLE 704-664-5281

65901

IMPROVEMENT PERMIT / CERTIFICATE OF COMPLETION / OPERATION PERMIT / EXISTING SYSTEM INSPECTION

PROPERTY DESCRIPTION NO. 26279 DATE 3-27-97 TAX MAP NO. Watershed: ☐ Yes ☐ No

OWNER OR CONTRACTOR Bryan LeFever PHONE: Business 878-7874 Home 528-4270

ADDRESS 2327 Buffalo Shoals Rd Statesville NC

LOCATION 40W TL Arquitrd TR Sandtrap Ln (Buffalo Hills Subdivision) 1st on left before cul-de-sac

SUBDIVISION Buffalo Hills BLOCK / SECTION LOT 19 LOT AREA SITE CLASS. P/S DESIGN FLOW 480 L.T.A.R. 0.3

Septic Tank: 1000 Gallons; STB Date

Pump Tank: Gallons; PT Date

Pump Make: Model Serial No.

Nitrification Field: No Fields 1 Square Feet 840 Linear Feet 280

No Lines 8 Trench Width 24in Max Trench Bottom Depth 36in Gravel Depth Sand

☒ New System ☐ Repair System Type: I, II, III, IV, V, VI

System Description: Panel - Gravity

Repair System Description: Pump Panels/Gravity Panel

Maintenance Agreement Required: ☐ Yes ☒ No

☒ House/Mod. Home No. Bedrooms 4

☐ Mobile Home No. Bathrooms 3

☐ Business No. Employees

☐ Other


☐ Slab ☐ Crawl Space ☒ Basement w/plumbing ☐ Basement wo/plumbing

Water Supply: ☐ Individual ☐ Community ☒ Public

Comments: keep lines on contour 8ft on center
use Efau divider split to 2 Dist. Boxes
8 panels Per line 8 lines Total - 1 in each side walls
Smooth out Terrace

Comments:

INITIAL SITE SKETCH

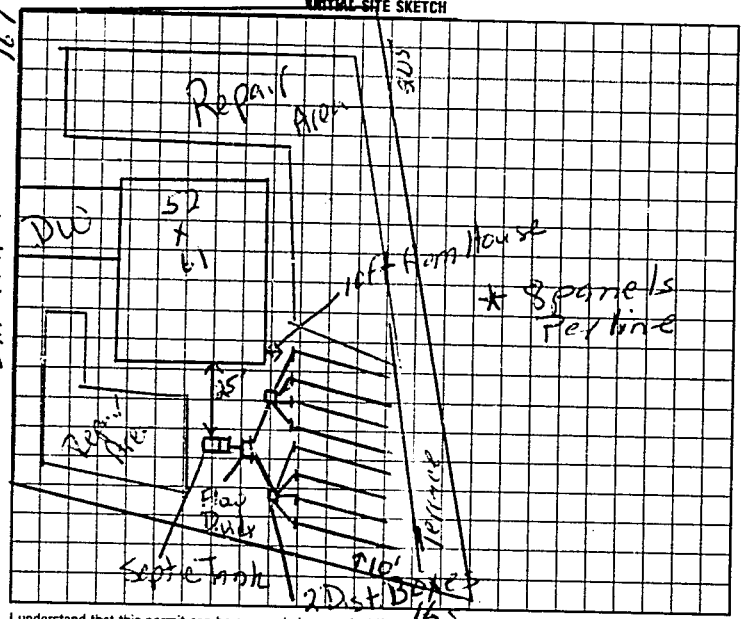

AS BUILT SKETCH

I understand that this permit can be suspended or revoked if any false information is supplied toward securing the permit/any unauthorized changes are made to the site/any unauthorized changes are made in the installation of the system. Improvement Permit is valid for 60 months from date of issuance. Authorization to construct expires 5 yrs from issue date

Signed: Bryan L LeFever

Improvement Permit by: Mary C Duffus date 3-27-97

Authorization to Const. Existing System Inspection by: Mary C Duffus date 3-27-97

Installed by:

Certificate of Completion by: date

Operation Permit by date

HEALTH DEPT. COPY: WHITE INSPECTION COPY (FINAL): GREEN OWNER COPY (FINAL): YELLOW INSPECTION COPY (INITIAL): PINK OWNER COPY (INITIAL): GOLD

6 6 5 1 0 0