IREDELL COUNTY HEALTH DEPARTMENT

STATESVILLE 704-878-5305 MOORESVILLE 704-664-5281

IMPROVEMENT PERMIT / CERTIFICATE OF COMPLETION / OPERATION PERMIT / EXISTING SYSTEM INSPECTION

PROPERTY DESCRIPTION NO. ~~26279~~ 06-901 DATE 10-6-97 TAX MAP NO. 4723 26 3969 Watershed: ☐ Yes ☐ No

OWNER OR CONTRACTOR Bryan Lefever PHONE: Business Home 528 4770

ADDRESS 2327 Buffalo Shoals Rd Statesville

LOCATION 70 W TL Airport Rd TR Sand Trap Lot on left before cul de sac

SUBDIVISION Brittany Hills BLOCK / SECTION LOT 19 LOT AREA SITE CLASS PS DESIGN FLOW 430 L.T.A.R. .13

Septic Tank: 1000 Gallons; STB 1007 Date 8-11-97

Pump Tank: Gallons; PT Date

Pump Make: Model Serial No.

Nitrification Field: No Fields 1 Square Feet 1600 Linear Feet 533

No Lines 4 Trench Width 36 Max Trench Bottom Depth 36 Gravel Depth 12"

☑ New System ☐ Repair System Type: I, II, III, IV, V, VI

System Description: Conv. Gravity

Repair System Description: " "

Maintenance Agreement Required: ☐ Yes ☑ No

☑ House/Mod. Home No. Bedrooms 4
☐ Mobile Home No. Bathrooms 3
☐ Business No. Employees
☐ Other

☐ Slab ☐ Crawl Space ☑ Basement w/plumbing ☐ Basement wo/plumbing


Water Supply: ☐ Individual ☐ Community ☑ Public

Comments:


Replaces Permit Issued 3-27-97 Drainfield Installed on Golf Course

Comments:

INITIAL SITE SKETCH

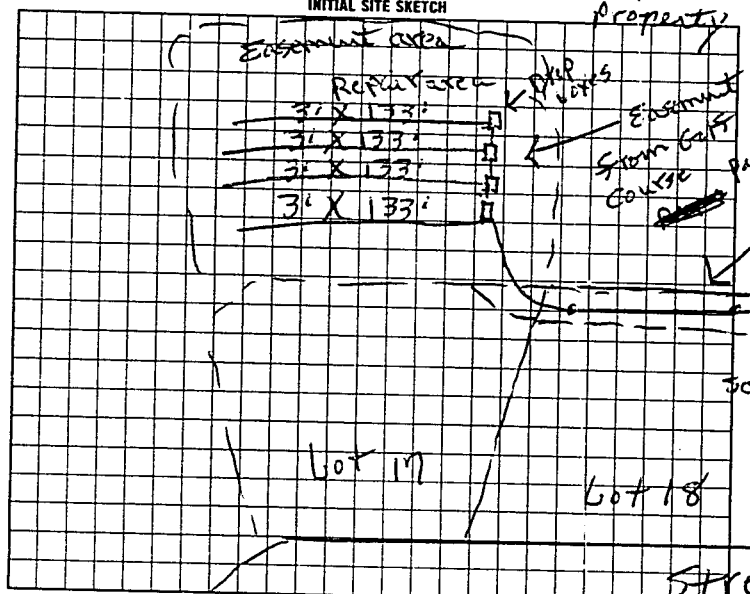

AS BUILT SKETCH

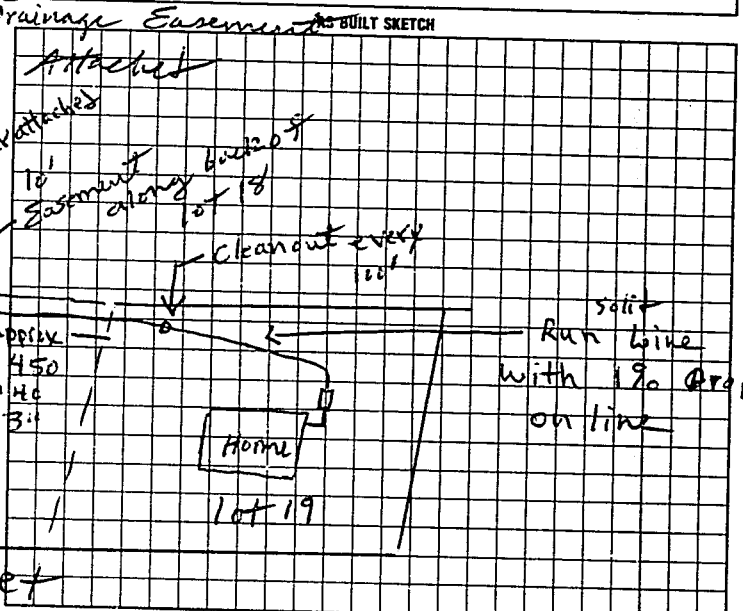

I understand that this permit can be suspended or revoked if any false information is supplied toward securing the permit/any unauthorized changes are made to the site/any unauthorized changes are made in the installation of the system. Improvement Permit is valid for 60 months from date of issuance.

Signed: X

Improvement Permit by: P.C. Moore date 10-6-97

Authorization to Cont. Existing System Inspected by: P.C. Moore date 10-6-97

Installed by: James Hutler

Certificate of Completion by: date

Operation Permit by: P.C. Moore date 10-8-97

HEALTH DEPT. COPY WHITE INSPECTION COPY (FINAL) GREEN OWNER COPY (FINAL) YELLOW INSPECTION COPY (INITIAL) PINK OWNER COPY (INITIAL) GOLD

to Cont. Authorization to cont. EXPIRES 60 mos from issue