IREDELL COUNTY HEALTH DEPARTMENT

STATESVILLE 704-878-5305 MOORESVILLE 704-664-5281

IMPROVEMENT PERMIT / AUTHORIZATION TO CONSTRUCT / OPERATION PERMIT / EXISTING SYSTEM INSPECTION

PERMIT # 154113 PIN # 4723265999 DATE 12/23/08

OWNER or APPLICANT Homer Shue PHONE: Business 704-202-7185 Home: 704-637-3451

OWNER or APPLICANT ADDRESS 111 REX RD Salisbury NC 28147

LOCATION / DIRECTIONS BUFFALO SHOALS SOUTH WEST (R) OLD Airport RD (L) STAY TRAP LOT ON RIGHT BY CUL-DE-SAC

SUBDIVISION Britain Hills BLOCK / SECTION LOT # 24 LOT AREA 26000sqft DESIGN FLOW 360 L.T.A.R. .3

Septic Tank 1000 Gallons: STB 1012 Date 7-7-08
Pump Tank Gallons: PT Date
Pump Make Model Serial #
Nitrification Field No Fields 1 No Lines 4 Linear Feet 300'
Trench Width 36" Max. Trench Bottom Depth 36" Gravel Depth N/A

☒ New System ☐ Repair ☐ Expansion System Type I II (III) IV V VI
System Description: GRAVITY 25% REDUCTION
Repair System Description: LP 50% REDUCTION
Maintenance Agreement Required ☐ YES ☒ NO
☒ GRAVITY ☐ PRESSURE

☒ Residence No. Bedrooms 3
☐ Business No. Persons 6
☐ Other No. Employees
☐ Slab ☒ Crawl Space
☐ Basement w/plumbing ☐ Basement w/o plumbing

Water Supply: ☐ Private ☒ Public ☐ Community

Comments / Conditions (1) System will be installed in area of 2% SLOPE OR LESS (2) NO BRUSH OR CUTTING BEHIND Home (3) SET Distribution BOX SO LINES WILL BALANCE TO BOX ; USE SPEED LEVELERS TO

Comments / Conditions SET EQUAL. (4) Shoot at Ground level of natural grade. (5) Shoot is 50' from (with of 1st Line AND IS DEAD LEVEL. (6) Shoot can be higher than natural grade & BACKFILL to cover, (7) ELEVATIONS

INITIAL SITE SKETCH

SET ATTACHED SYSTEM DESIGN BY LOCKE LOOK, P.S.

AS BUILT SKETCH

SHOT WITH LAZER AND MAXIMUM TRENCH BOTTOM OF 36" OR SHALLOWER CAN BE ALLOWED

(8) IF Shoot IS TO LOW, pump system maybe required.

Red Lid Lite Septic Marker

Permit can be suspended or revoked if any false information is supplied toward securing the permit / any unauthorized changes are made to the site / any unauthorized changes are made in the installation of the system.

☐ IMPROVEMENT PERMIT w / plat valid without expiration. ☒ IMPROVEMENT PERMIT w / site plan valid for 60 mos. ☐ AUTHORIZATION TO CONSTRUCT valid for period equal to IMPROVEMENT PERMIT-not to exceed 60 mo.

Owner / Applicant Signature: Date 12-29-08

Improvement Permit by: Date 12/23/08

Authorization to Construct by: Date 12/23/08

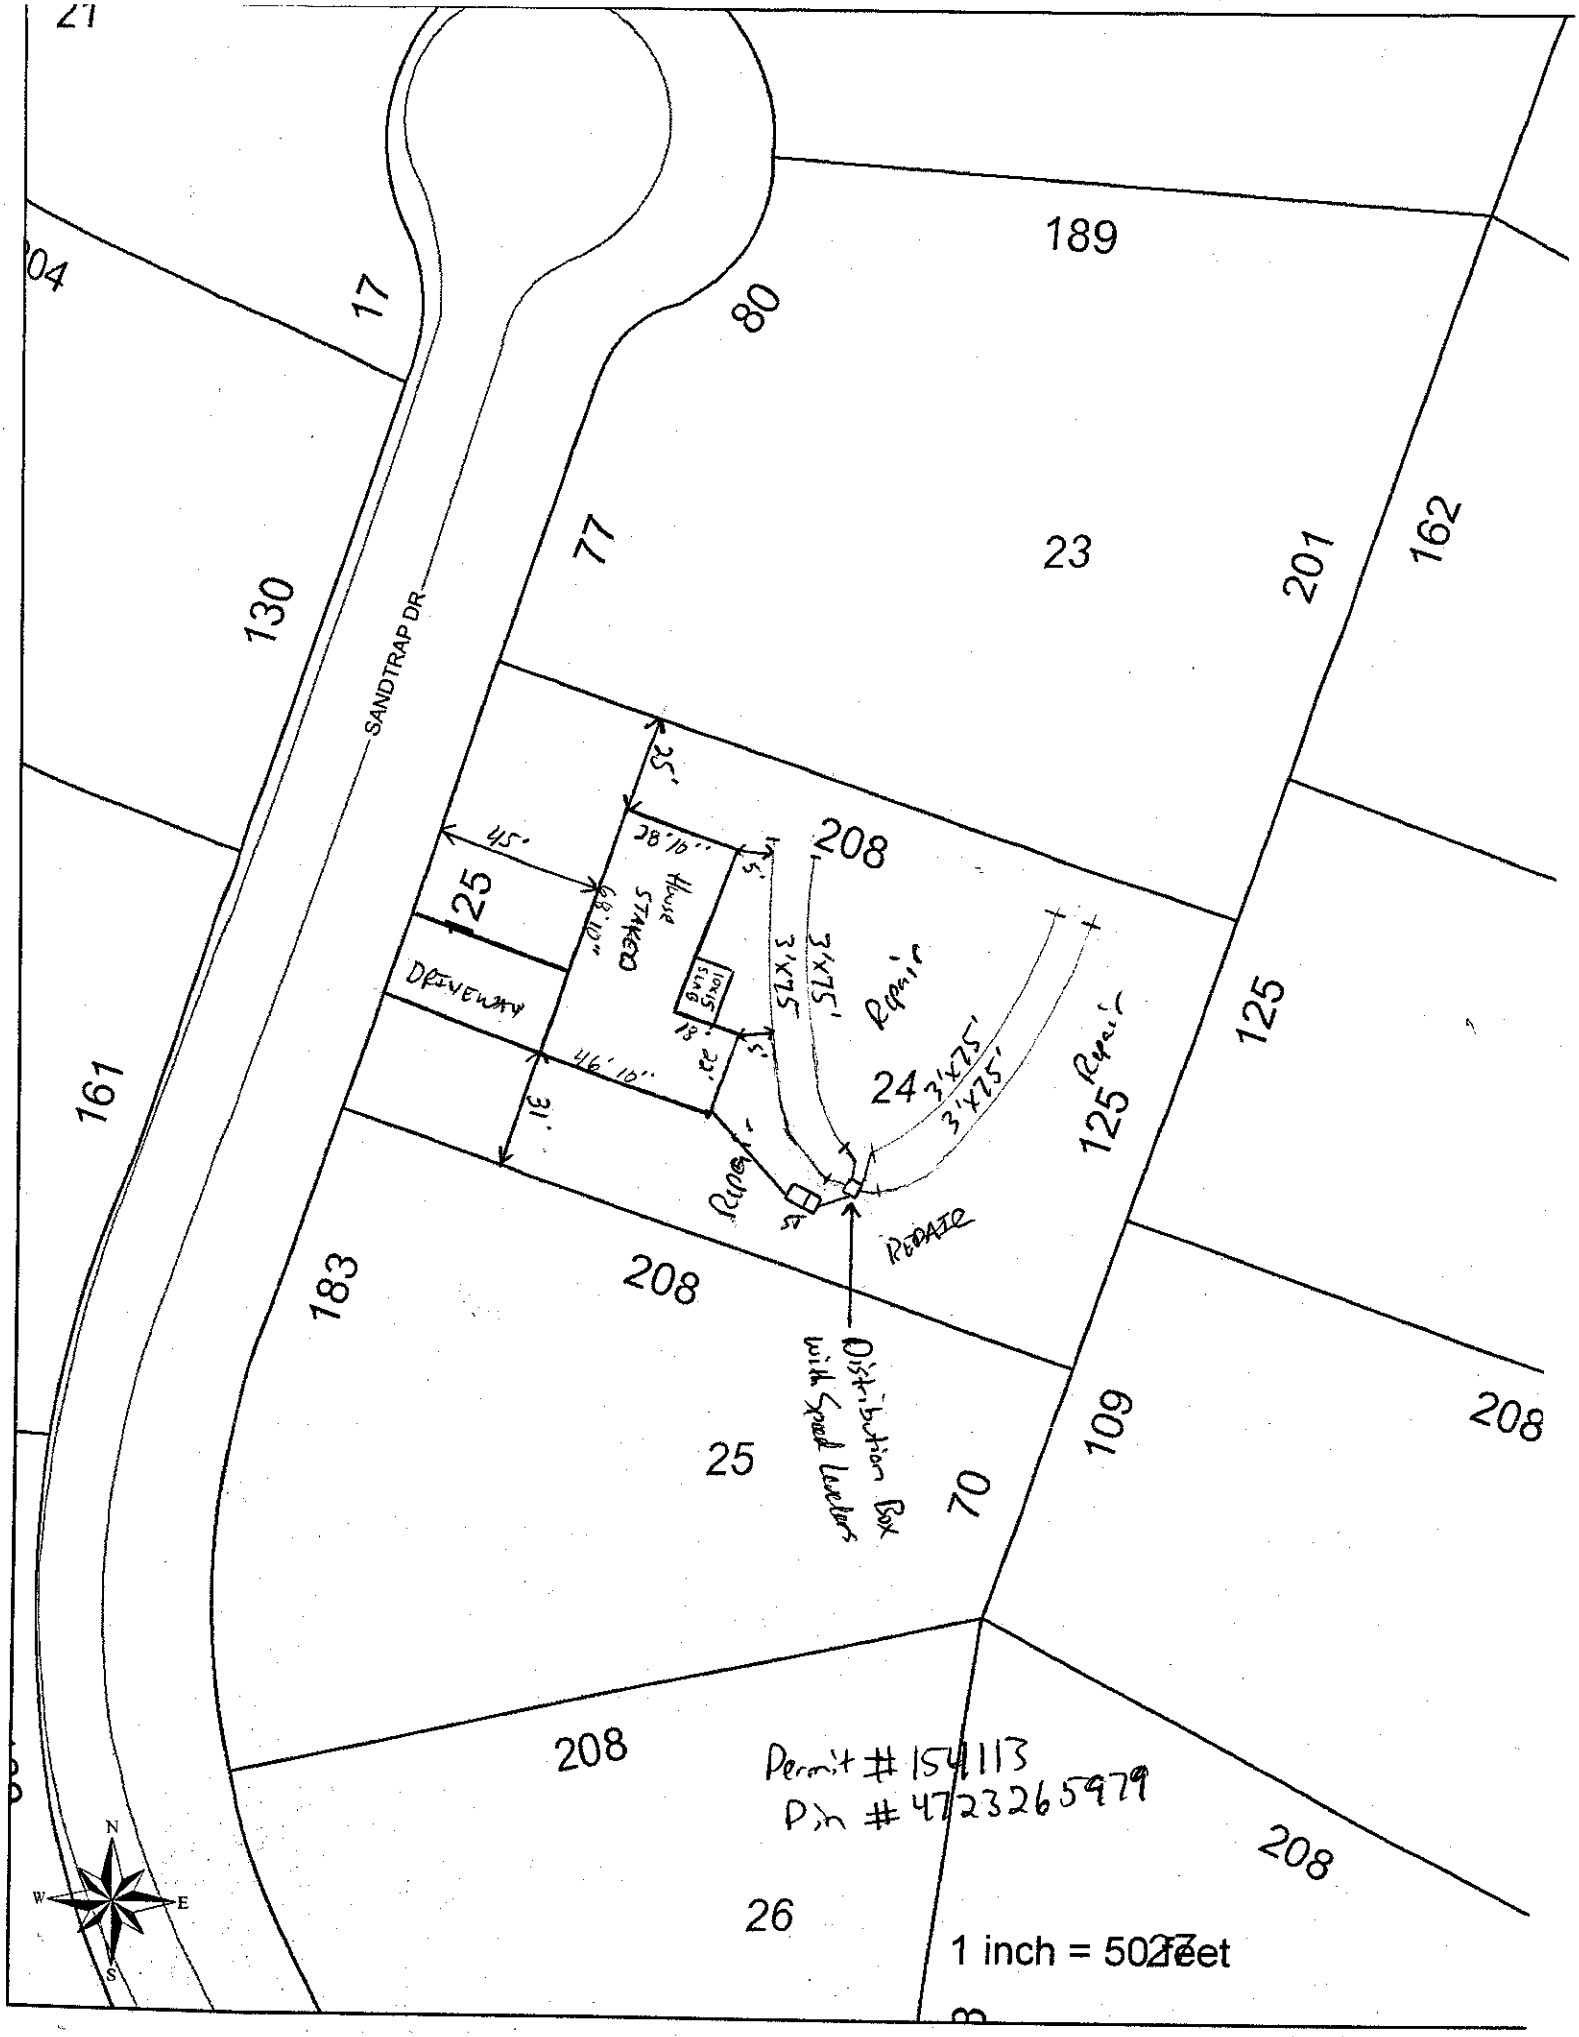
YOU SHOULD CONTACT A LOCATOR SERVICE PRIOR TO ANY EXCAVATION.

Installed by: David Young

Operation Permit by: Date: 3-18-10

Existing System Inspected by: Date:

WHITE COPY Environmental Health YELLOW COPY (Final) Owner / Applicant PINK COPY (Initial) Owner / Applicant


SANDTRAP DR
189
17
80
77
23
201
162
130
161
125
208
183
25
109
70
26
House STAKED
Driveway
45'
25'
38'10"
68'10"
46'10"
31'
3'x75'
3'x25'
Repair
Distribution Box with Speed Levelers
Permit # 154113
Pin # 4723265979
1 inch = 50 feet
N
S
E
W